


32625

15

34-6-12

# T.34S.R.6W.W.M.

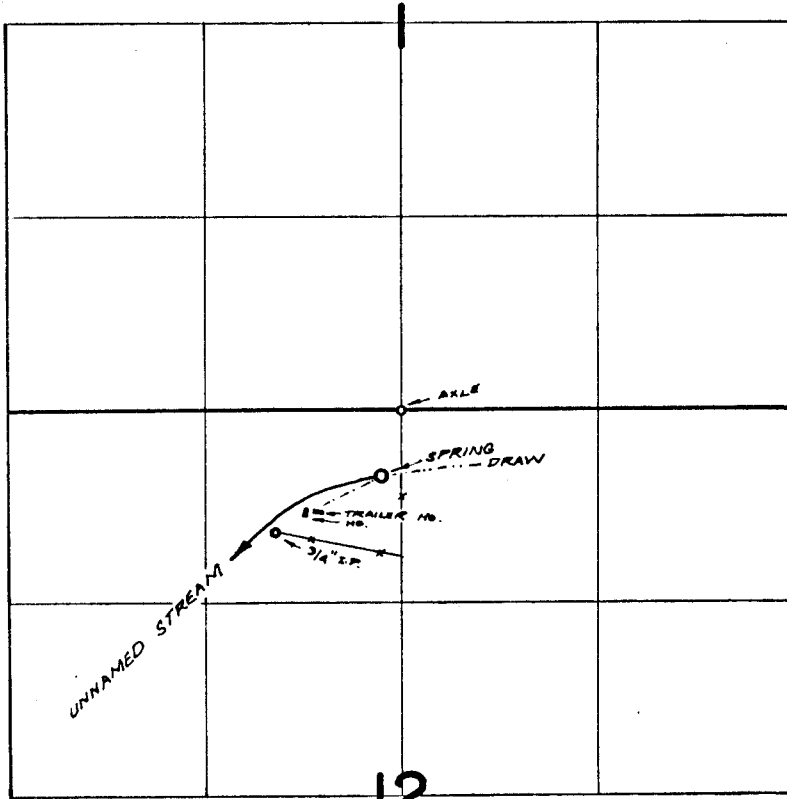

12

DIV. PT. LOC: 450'S. & 130'W. FROM N. 1/4 COR. SEC. 12

## FINAL PROOF SURVEY UNDER

Application No. ~~43632~~..... Permit No. 32625.....  
IN NAME OF

.....DORTHEA M. BROCK.....

Surveyed APRIL 16, 1970., by R. MUCKEN.....