


SECTION 22. T. 34 S. R. 1 W. W. M.

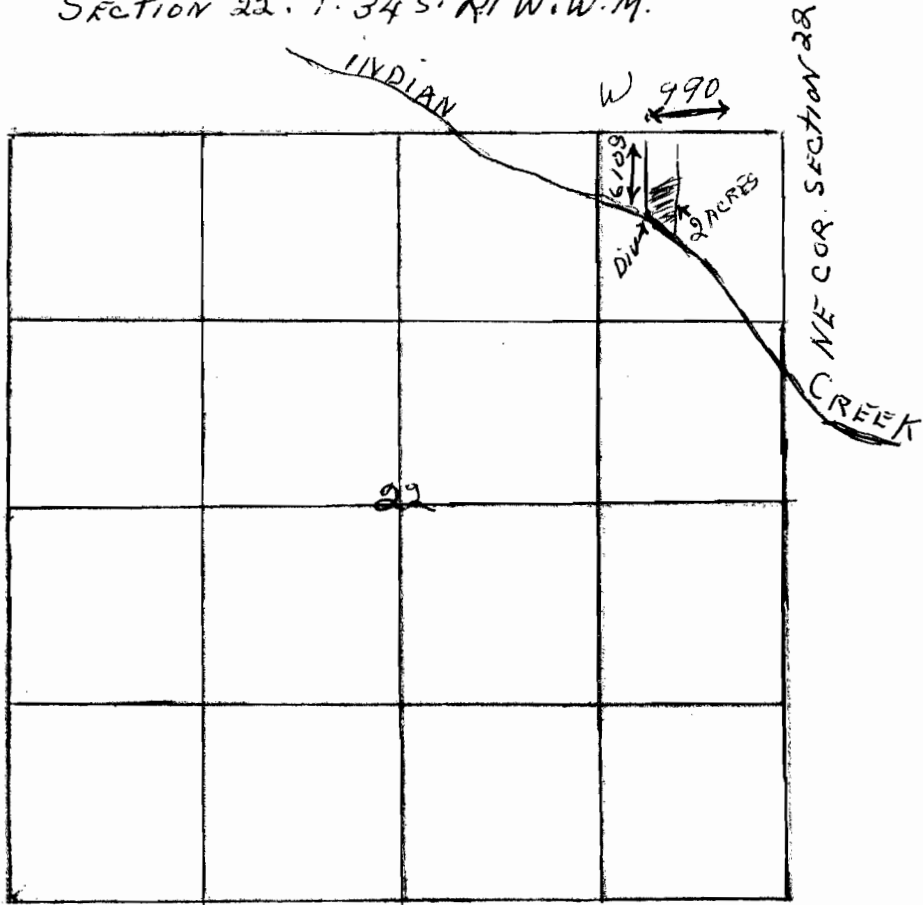

RECORDED

MAR 3 1967

REGISTERED ENGINEER

Applicant
D.

43646
32628