


32633 15  
37-5-25

# T. 37 S. R. 5 W. W.M.

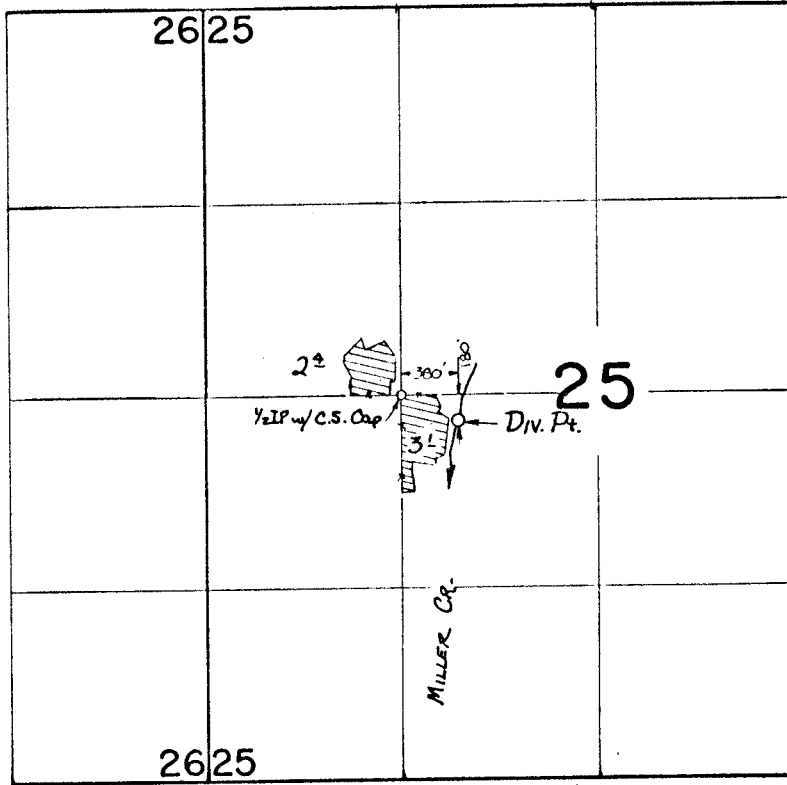

## FINAL PROOF SURVEY UNDER

Application No. 43653    Permit No. 32633  
IN NAME OF

THOMAS C. SCHULTZ

Surveyed 30 APRIL, 1970, by D. R. BUELL

1970.025