


232/

MAP
 ACCOMPANYING APPLICATION
 OF THE
 PACIFIC LIVE STOCK CO
 TO APPROPRIATE WATER
 FROM
 TROUT CREEK
 SEC 18 T395 R37E

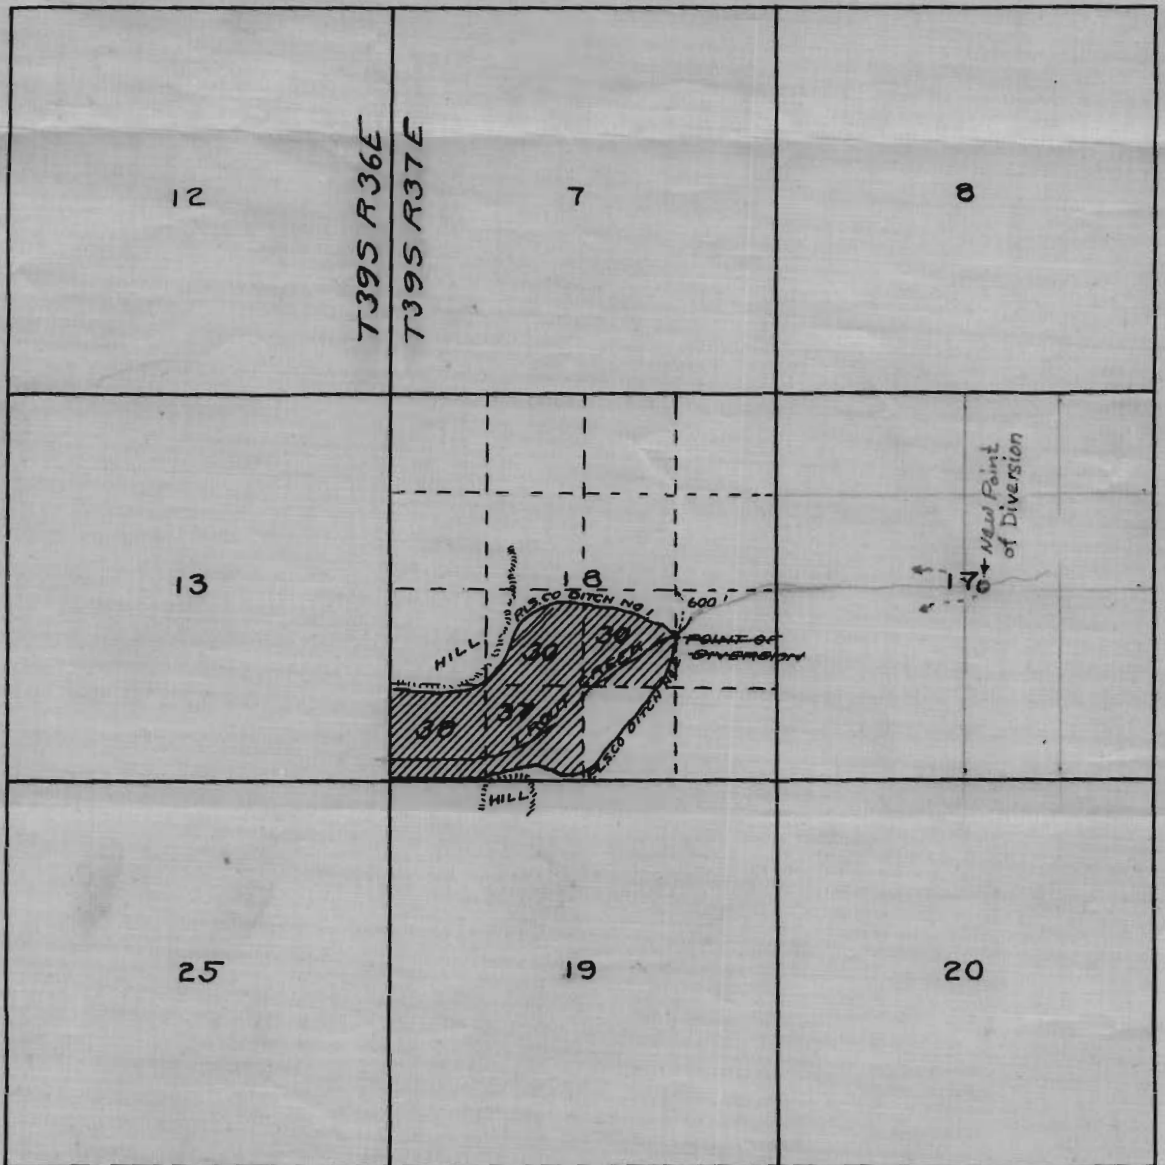

232/

OFFICE OF STATE ENGINEER
 RECEIVED
 FEB 2 1913
 SALEM, OREGON

Application No. 538/
 Permit No. 3264