


State of Oregon }
 County of Lane }
 I, W.B. Lillard, hereby certify that this is an exact copy of the original filed in Book 9 Page 28 of the Public Records of Lane County, Oregon.
 W.B. Lillard
 County Clerk

DEERHORN

SECTION, 17. T.P. 17. S. R. 1. E. W.M.

LANE COUNTY OREGON

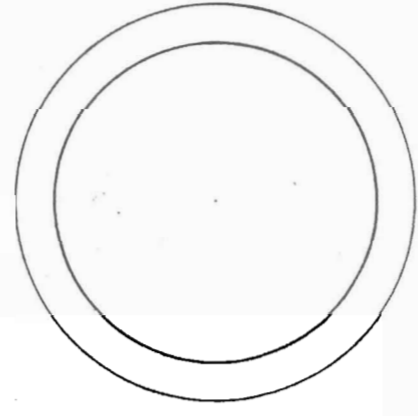

State of Oregon }
 County of Lane }^{ss} On this the 12th day of April, 1927,
 Personally appeared before me a notary public in and for said county and state the following named V.L. Ruiter and Mae E. Ruiter his wife personally known to me to be the identical persons described in, and who executed the following dedication and who acknowledged to me that they executed the same freely for the uses and purposes therein named. In testimony whereof I have hereunto set my hand and affixed my official seal, this 12th day of April 1927.

Whitten Swafford
 Notary Public for Oregon
 My Commission expires 2/5/1928

DESCRIPTION

Being, Lot, 3, of section, 17, Township, 17, South, Range, 1, East, Willamette Meridian, Oregon, Described as follows: Beginning at the southwest corner of said lot, 3, on the right bank of the McKenzie River, thence, along said right bank, in an Easterly direction to the Southeast corner of said Lot, 3, thence North, along the East line of lot 3, 1164 feet to the Northeast corner of said Lot, 3, thence West, along the North line of Lot, 3, 1320 feet to the Northwest corner thereof thence South, along the West line of Lot, 3, 1160 feet to the place of beginning containing 32.82 acres in Lane County Oregon.

DEDICATION

State of Oregon }
 County of Lane }^{ss}
 Know all men by these presents that the McKenzie River Highway Sanitarium Company, a corporation duly organized and existing under the laws of the State of Oregon, has by these presents conveyed to the public the fee simple of the land included within the boundaries of the Plat of Deerhorn, and does hereby lay out and establish the subdivisions as shown upon this plat, and does hereby dedicate to the free use of the public the streets and roadways, as hereon shown, to be used as such forever. In witness whereof, the McKenzie River Highway Sanitarium Company has caused these presents to be signed by its president and secretary in accordance with a resolution of its board of directors heretofore duly adopted.

V. L. Ruiter President
 Eugene Kester Secretary
 Done in the presence of Whitten Swafford Gertrude Bauer
 V. L. Ruiter Mae E. Ruiter
 Done in the presence of Whitten Swafford & H. Waggoner.

ACKNOWLEDGMENT

State of Oregon }
 County of Lane }^{ss}
 On this the 9th day of February 1927 personally appeared before me a notary public in and for said county and state the above named V.L. Ruiter, president and Eugene Kester secretary of the McKenzie River Highway Sanitarium company, a corporation, and that the said instrument was signed in behalf of said corporation, by authority of its board of directors, and that the said V.L. Ruiter and Eugene Kester acknowledged said instrument to be the free act and deed of said corporation. In testimony whereof I have hereunto set my hand and affixed my official seal on this day and year first above mentioned.



Whitten Swafford Notary Public for Oregon.
 My Commission expires February 5th 1928.

SURVEYORS AFFIDAVIT

State of Oregon }
 County of Lane }^{ss}
 I, G.H. Waggoner being first duly sworn on oath say that I have surveyed the land included within the boundaries of the Plat of Deerhorn and that I planted for initial points asphalt stone 6x6x12 ins., six inches below the surface of the ground, marked with a cross at the South east corner of lot 1, block 1, of this plat, also a similar stone marked and planted in a similar manner, at the Northeast corner lot 9, block 1, of this plat for location of this plat refer to the description.

G.H. Waggoner
 Professional Engineer
 Certificate, Oregon, No 954
 Dated Dec. 31st 1919
 Subscribed and sworn to before me this 17 day of March 1927

H. E. Slattery
 Notary Public for Oregon.
 My commission expires September 16, 1928

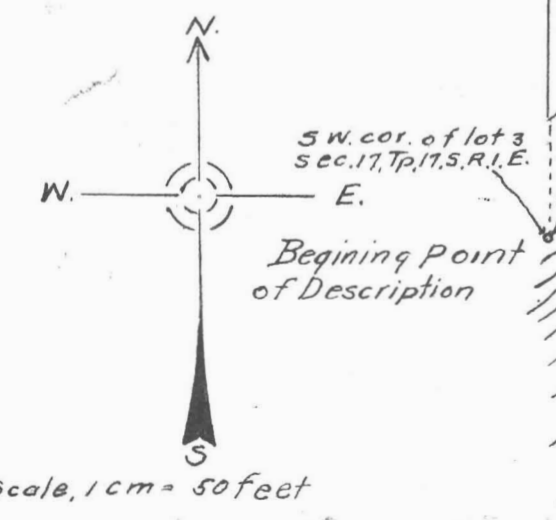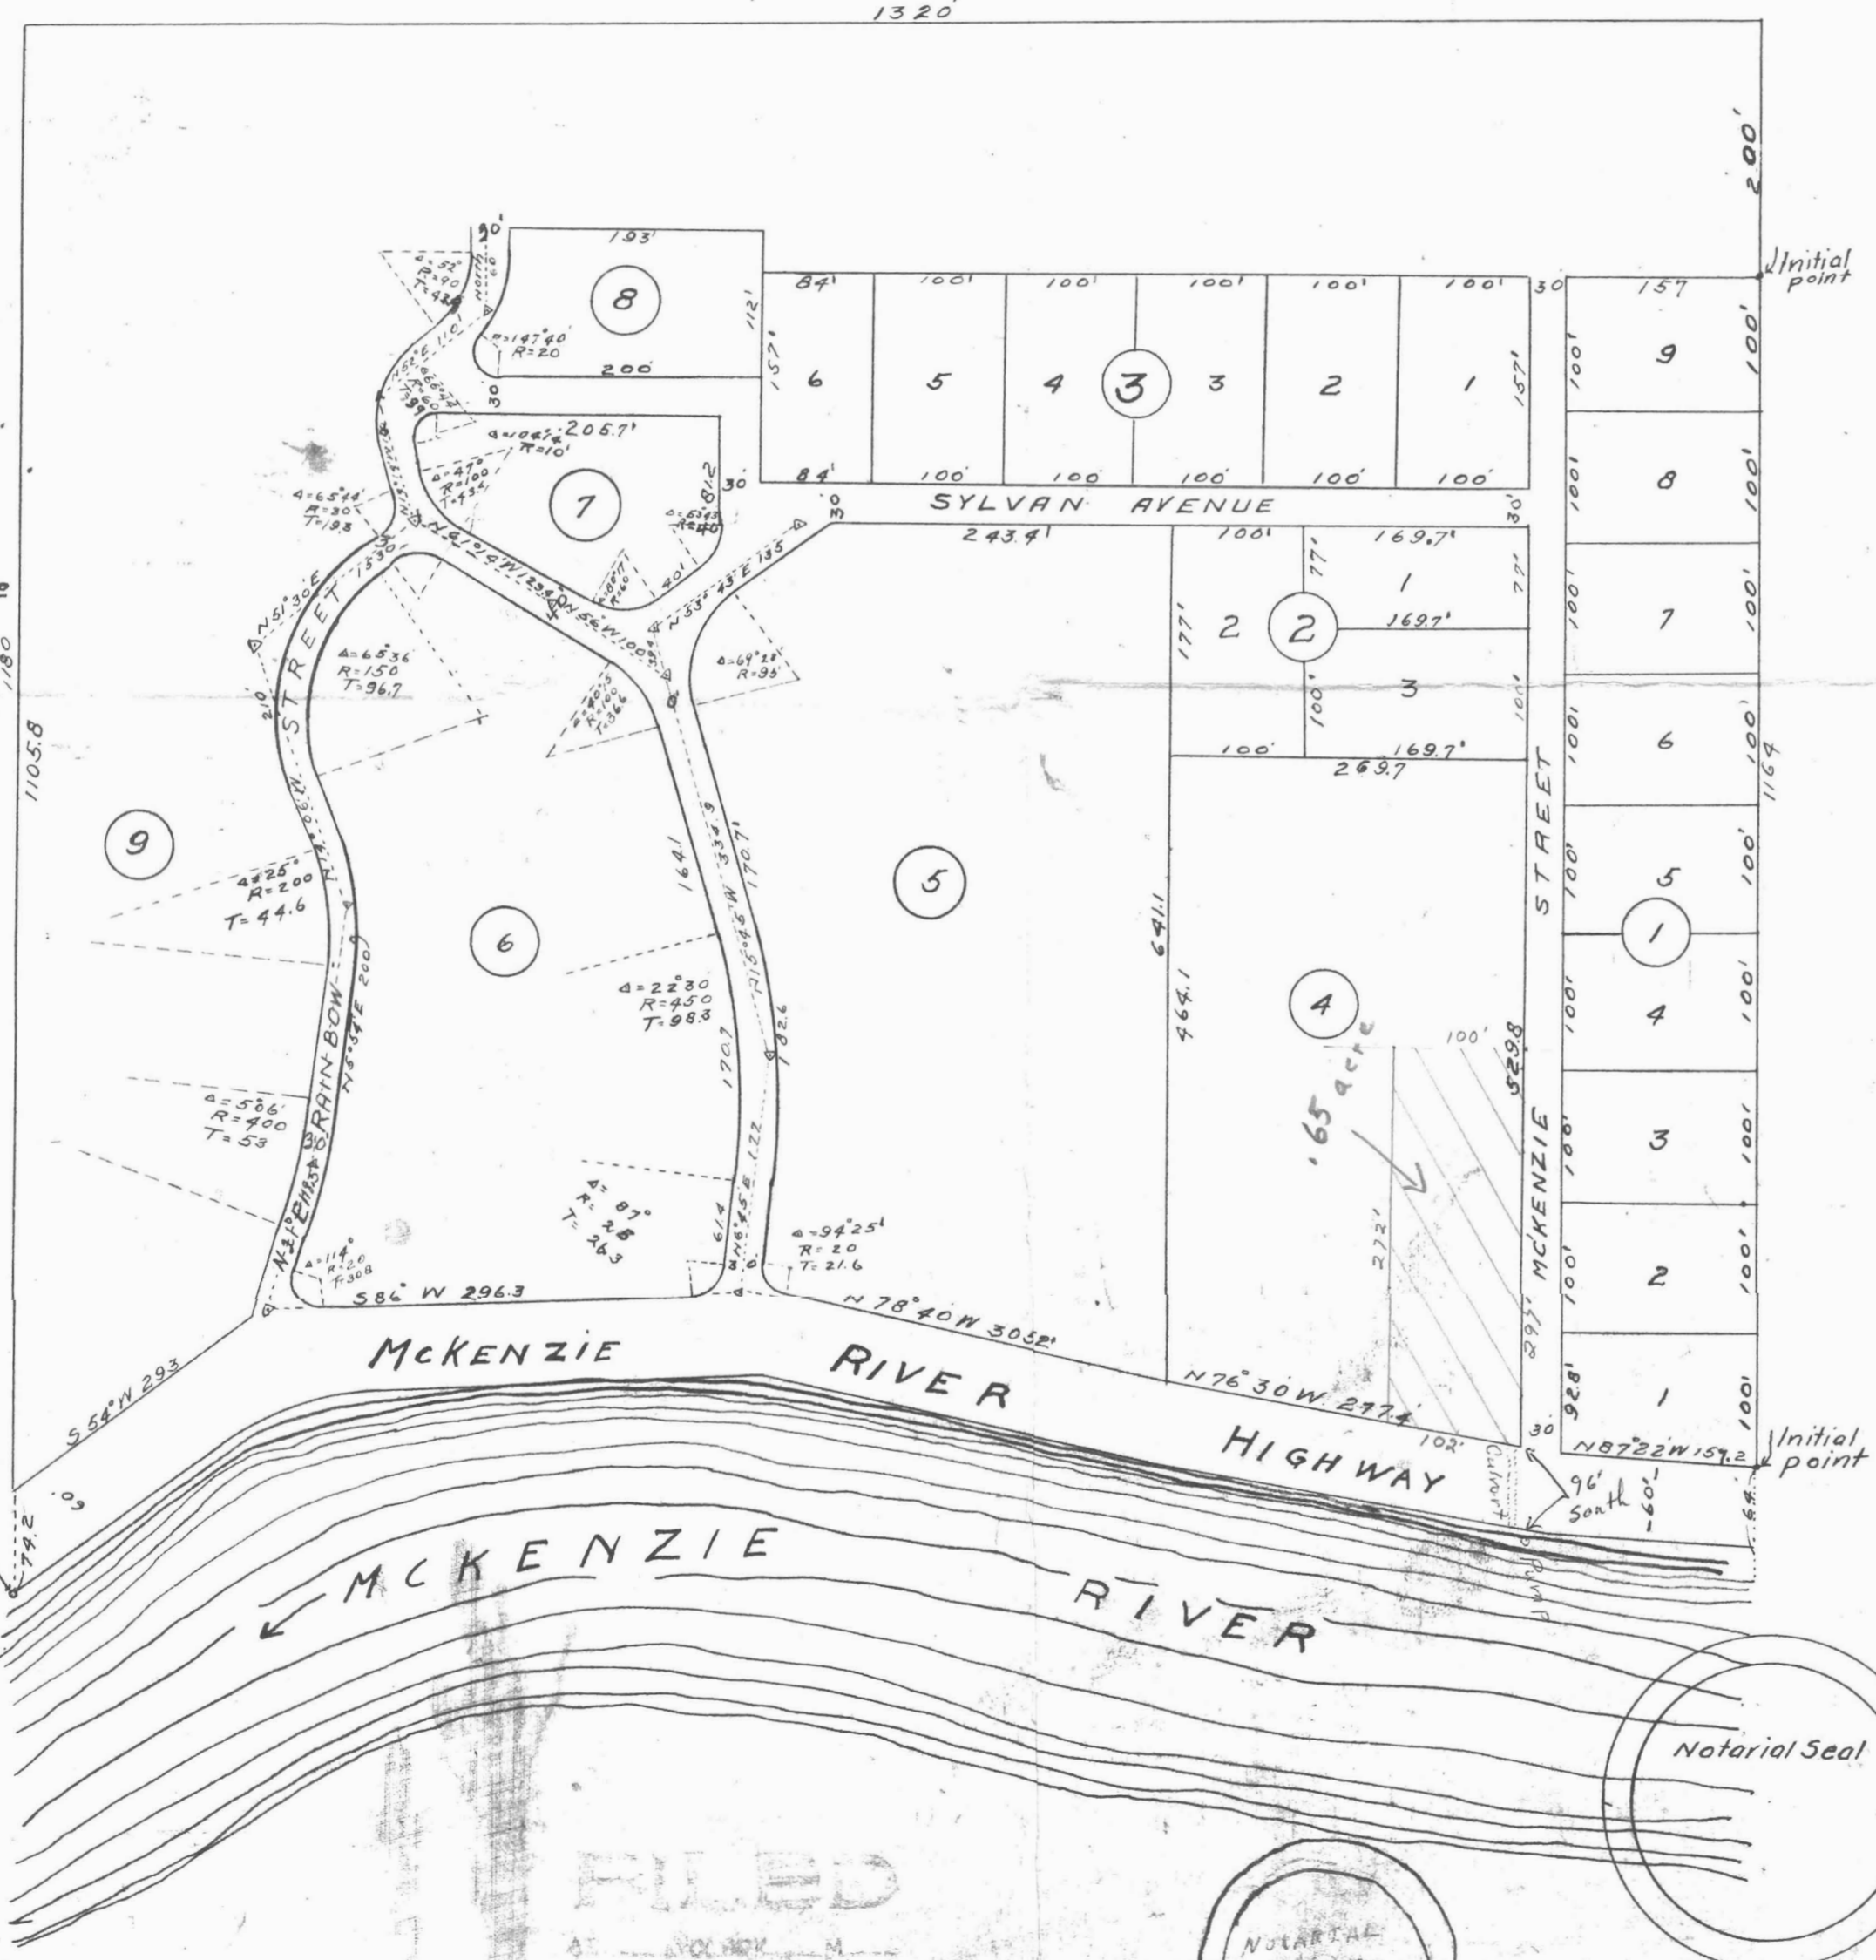

FILED

APR 12 1927

W.B. Lillard
 County Clerk



Approved
 C.F. Barnard
 Clinton Hurd
 O.E. Crowe
 Benj. E. Heeney
 P.M. Morse

Application No. 43013
 Permit No. 32647
 RECEIVED
 JUL 31 1927
 STATE ENGINEER
 SALEM, OREGON
 RECEIVED
 OCT 25 1927
 STATE ENGINEER