


T. 35 S. R. 5 W. W. M.

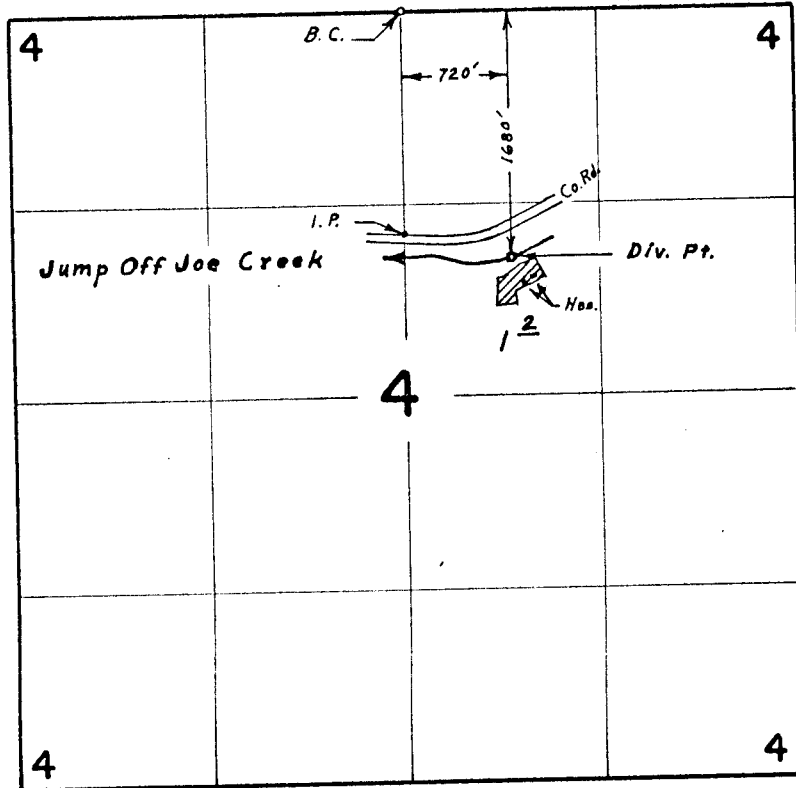

FINAL PLAN OF SURVEY

UNDER

Application No. 44089 Permit No. 32732

IN NAME OF

J. G. & LORENTINA J. McWILLIAMS

Surveyed April 13, 1970, by L. E. Gould