


35-5-4
32733

15

T. 35 S. R. 5 W. W. M.

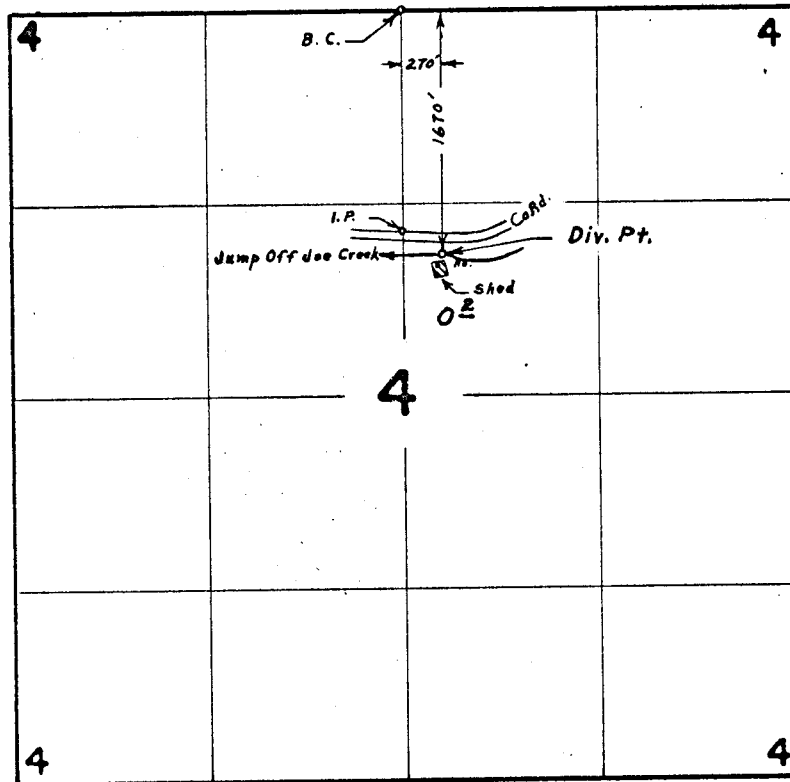

FINAL PROOF SURVEY

UNDER

Application No. 44093 Permit No. 32733

IN NAME OF

WILLARD A. HOLT

Surveyed April 13, 1970, by L. E. Gould