


T.38 S. R.5 W. W.M.

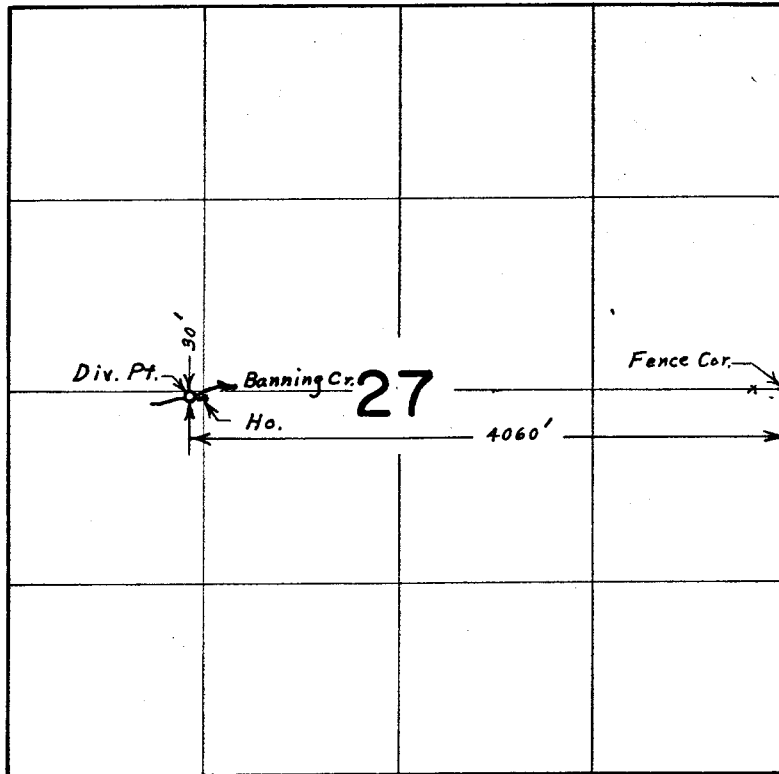

**FINAL PROOF SURVEY**  
UNDER

RECEIVED

APR 28 1980

WM. DIST. 14  
GRANTS PASS, ORE.

Application No. 44231 Permit No. 32736  
IN NAME OF

Cert # 49127

MS. DEBBIE MILLION

Surveyed Sept. 16, 1975, by L. E. Gould  
Inspection: April 4, 1979 by B. R. Sund