


SECTION

14

23

TOWNSHIP 10S, RANGE 38E, W.M.

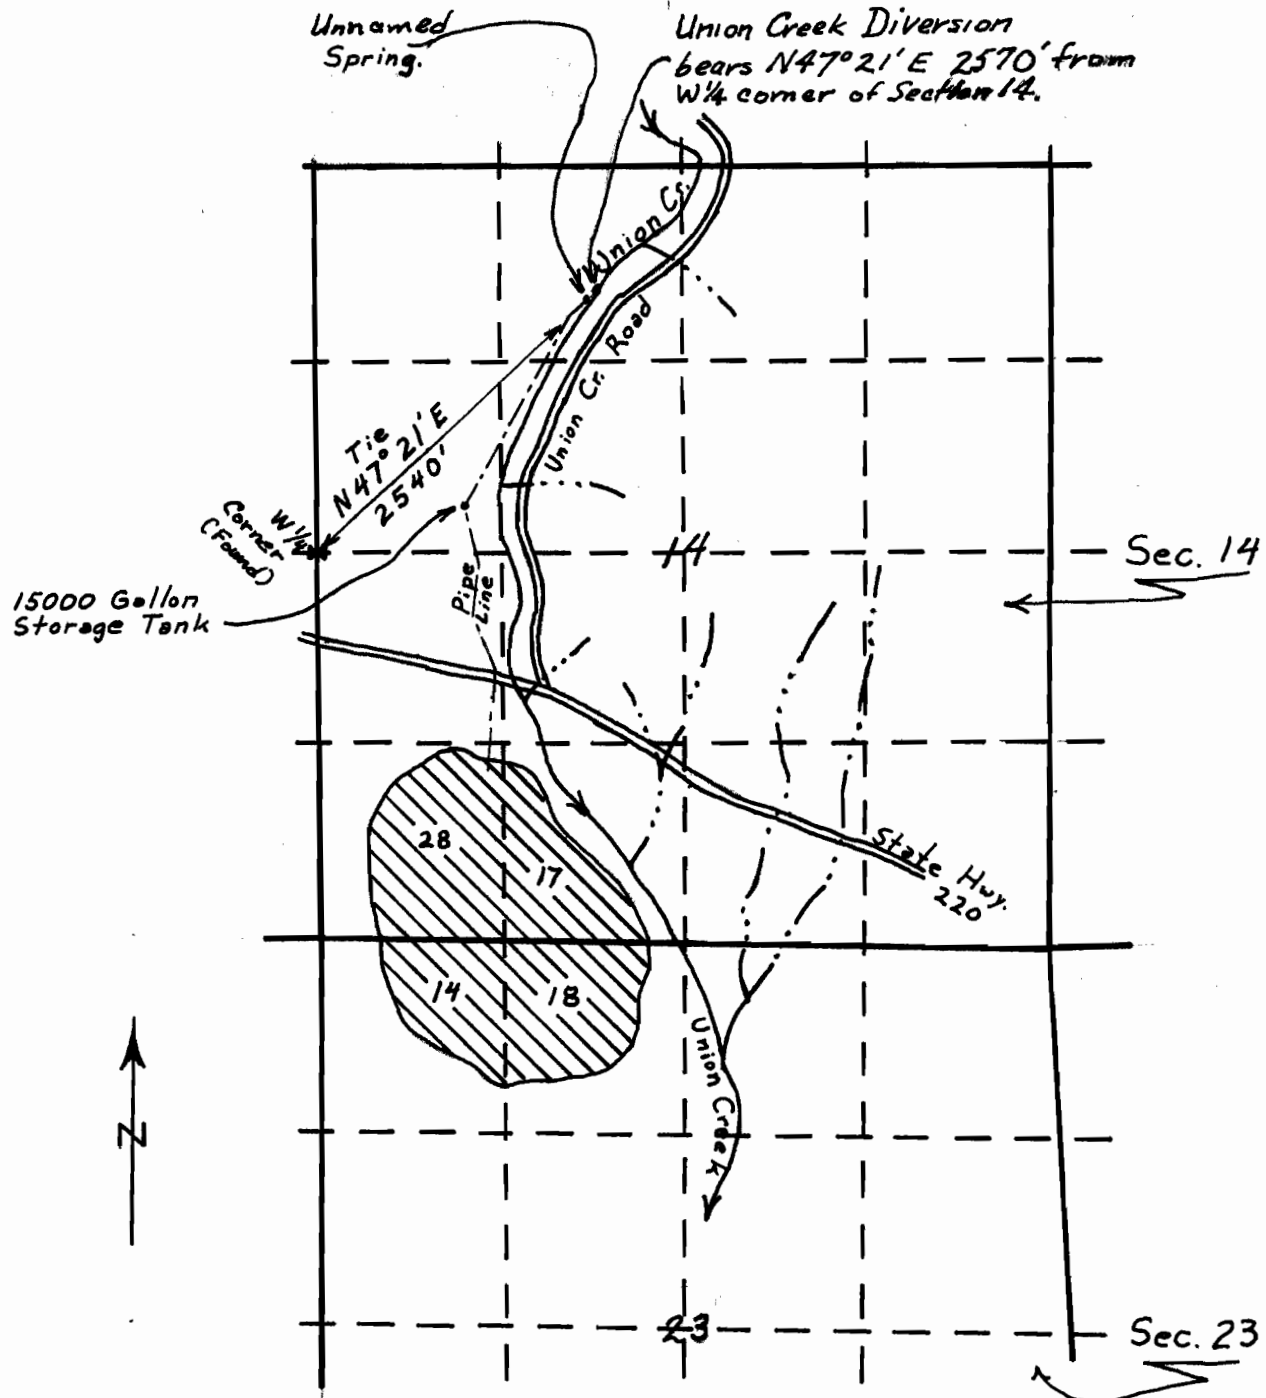

43815  
30757

APPLICATION No. \_\_\_\_\_  
PERMIT No. \_\_\_\_\_