


PLAT SHOWING LOCATION OF FRANK STUBBLEFIELD DITCH WALLOWA CO. OREGON.

SCALE 1" = 400'

TWP. 2 SOUTH

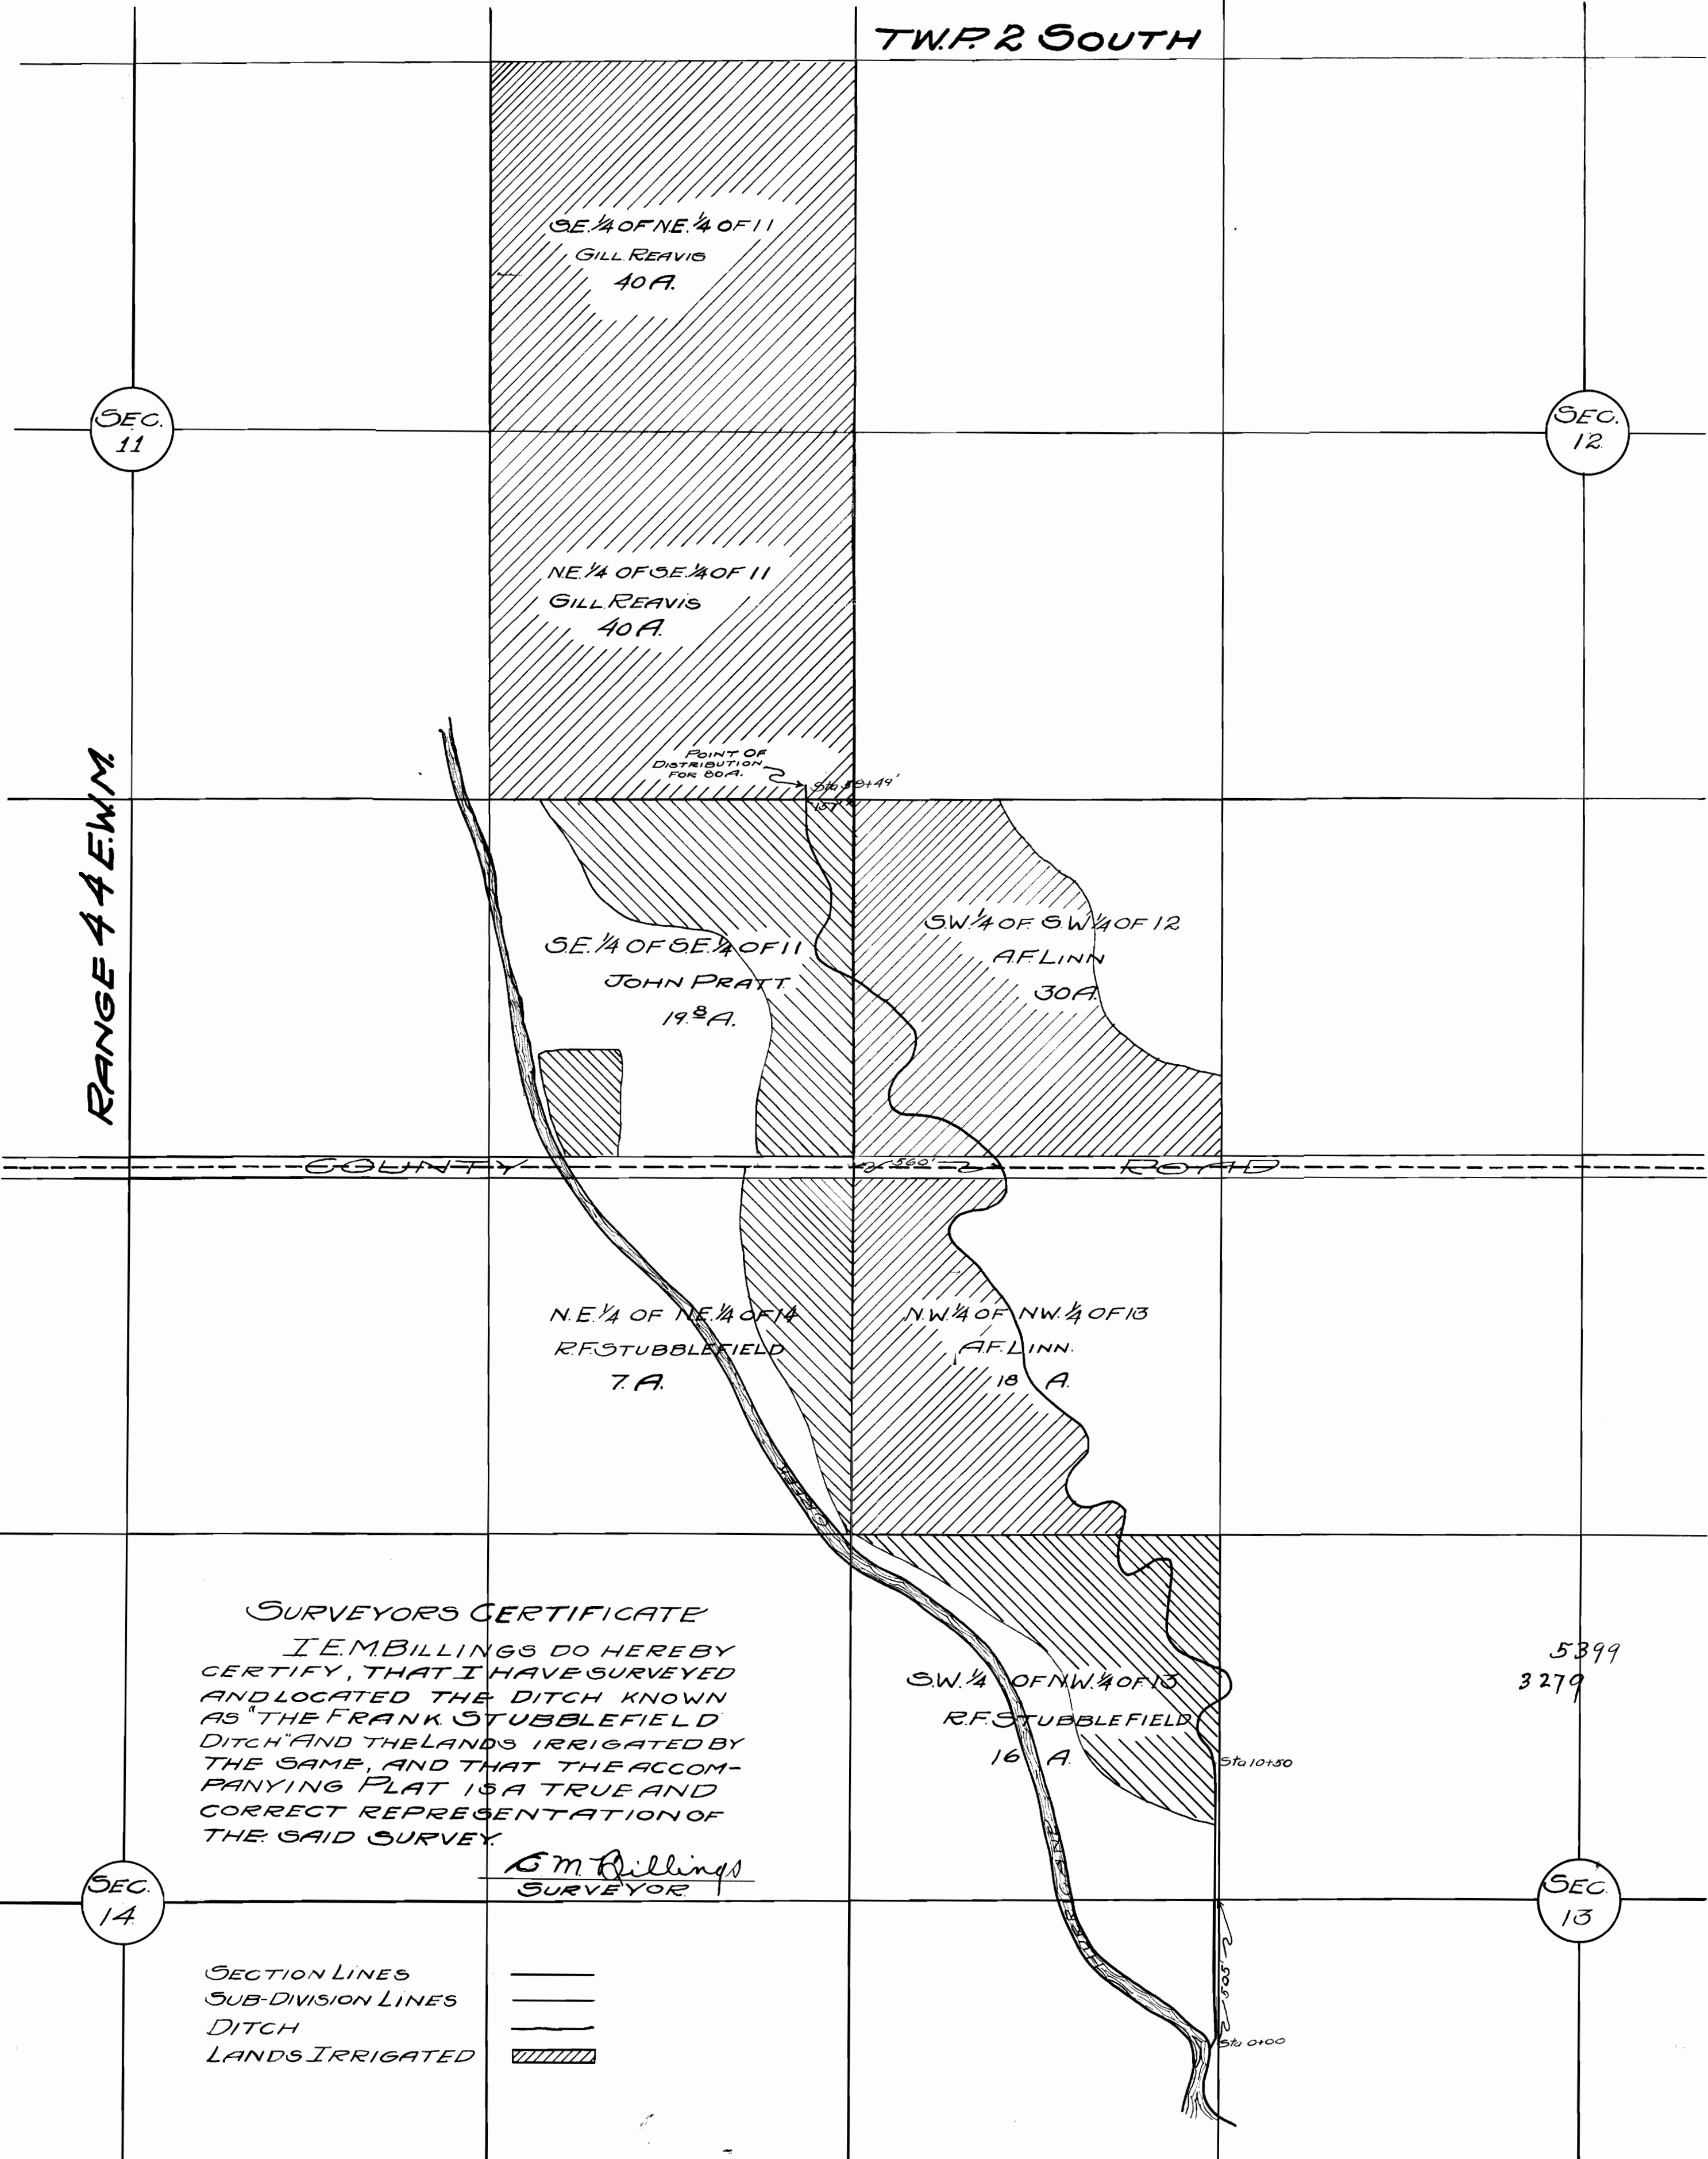

SEC. 11

SEC. 12

RANGE 44 E. W.M.

COUNTY ROAD

SURVEYORS CERTIFICATE
I, E.M. BILLINGS DO HEREBY CERTIFY, THAT I HAVE SURVEYED AND LOCATED THE DITCH KNOWN AS "THE FRANK STUBBLEFIELD DITCH" AND THE LANDS IRRIGATED BY THE SAME, AND THAT THE ACCOMPANYING PLAT IS A TRUE AND CORRECT REPRESENTATION OF THE SAID SURVEY.

E.M. Billings
SURVEYOR

5399
3279

SEC. 14

SEC. 13

- SECTION LINES
- SUB-DIVISION LINES
- DITCH
- LANDS IRRIGATED