


32792  
36-7-11

# T. 36S. R. 7W. W.M.

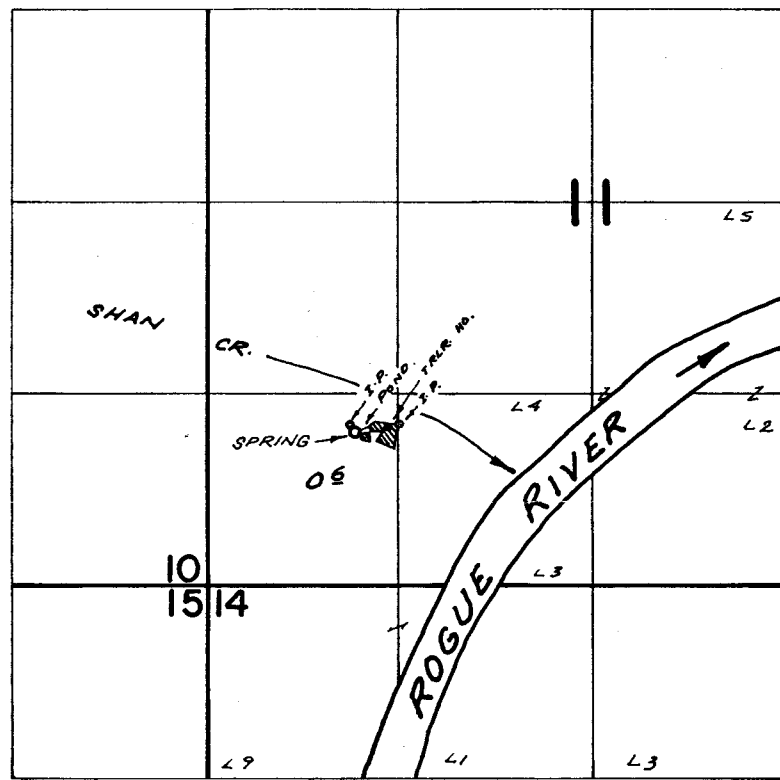

SPRING LOC: 270'S. & 300'W. FROM NE COR. SW 1/4 SW 1/4 SEC. 11

## FINAL PROOF SURVEY UNDER

Application No. 44115 Permit No. 32792  
IN NAME OF

VIRGINIA DEVERMIN

Surveyed APR. 19, 1972, by R. MUCKEN