


T. 35S. R. 7W. W.M.

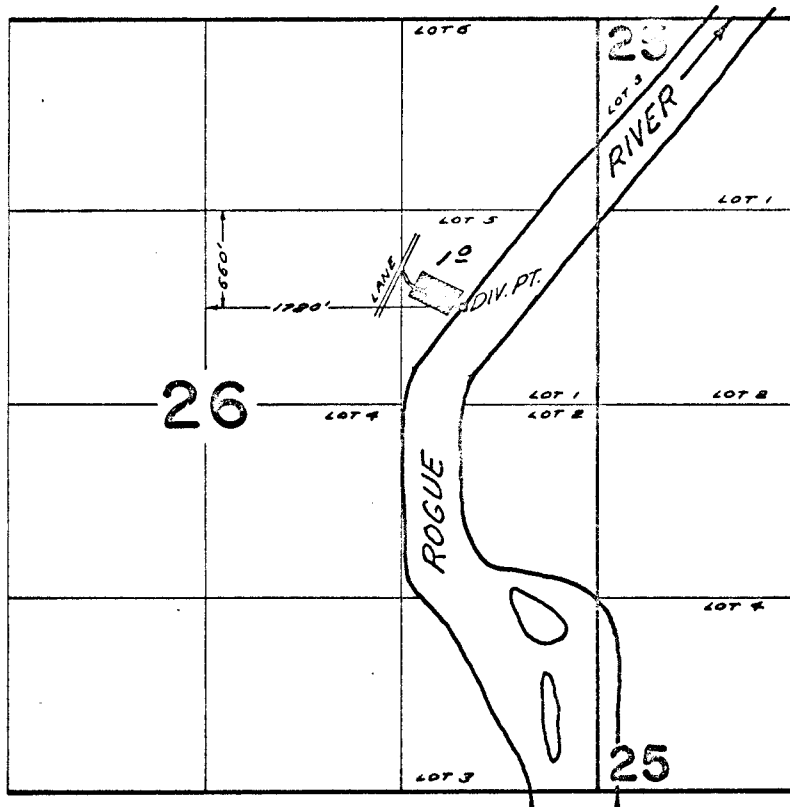

FINAL PROOF SURVEY UNDER

Application No. 43894 Permit No. 32810
IN NAME OF

HAROLD W. RETZLOFF

Surveyed JUN. 6. 19.69, by D. BUELL