


32816

T.34S.R.6W.W.M.

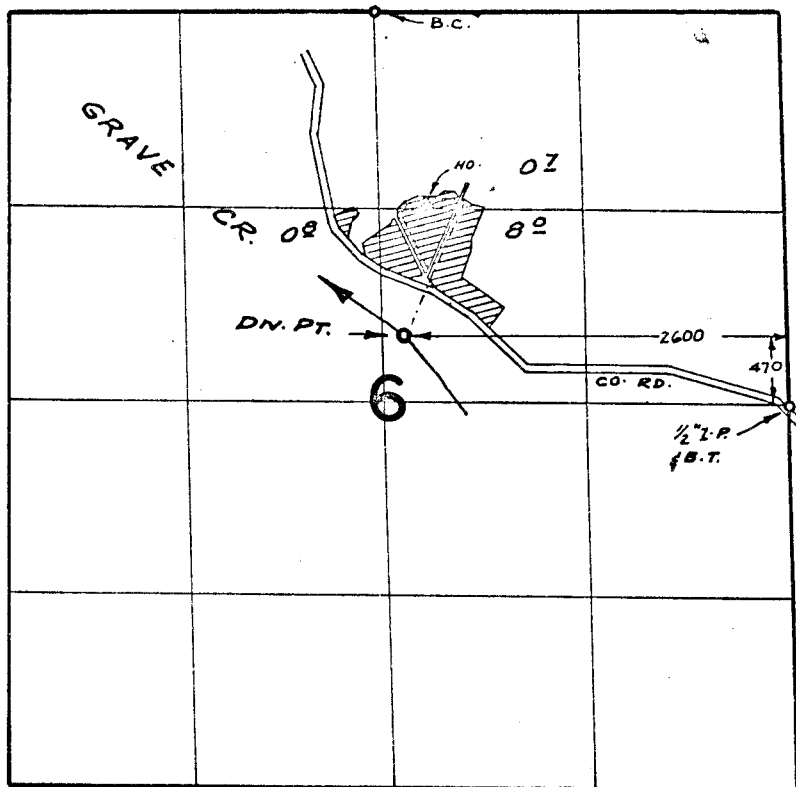

FINAL PROOF SURVEY UNDER

Application No. 43907... Permit No. 32816...
IN NAME OF

THOMAS K. & DONNA J. JOSSERAND

Surveyed APR. 12, 1972, by R. MUCKEN

C-29277