



Township 37 S;

Range 7 W.

Corrected filing
by Mr. Dyke

Jan-10-1917
CJS

2300

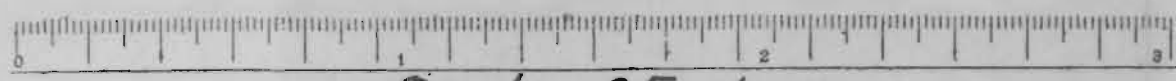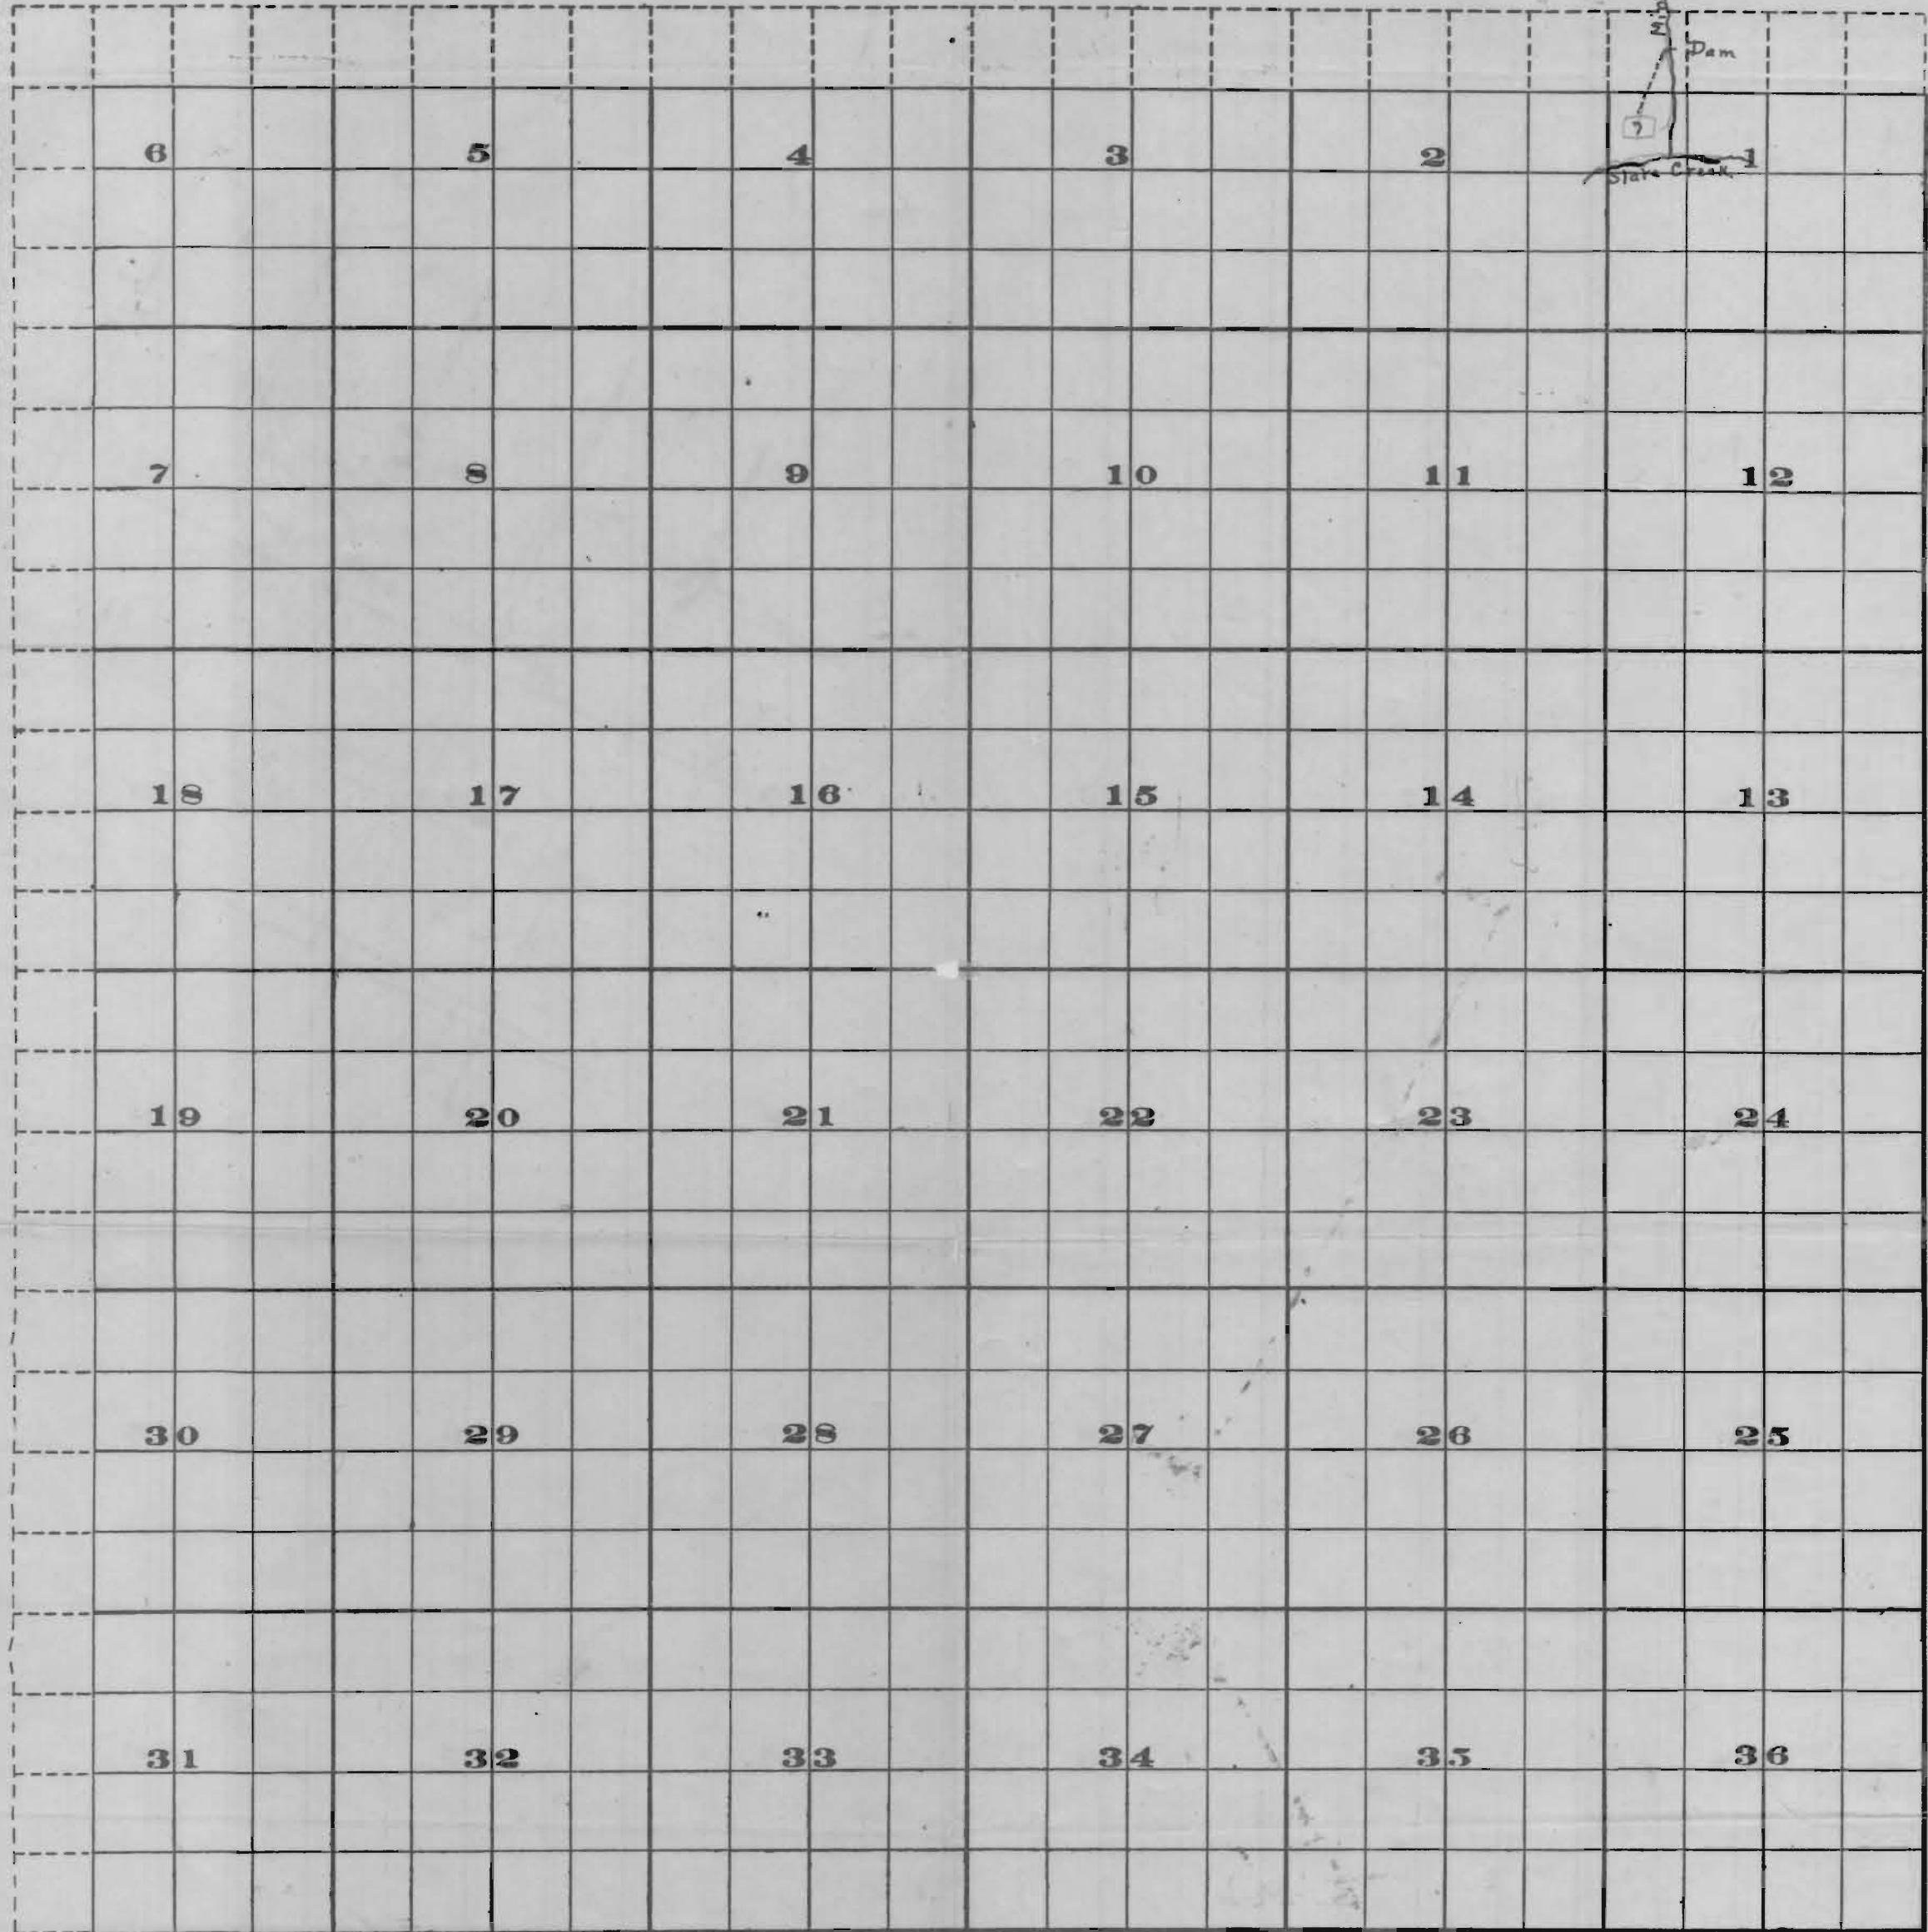

Scale of Feet.

FROM OFFICE OF THE STATE ENGINEER, SALEM, OREGON

Application No. 5300
Permit No. 3284

2300

2300