


Section 35  
 Twp. 5S; R. 7W.  
 Scale 1" = 400'

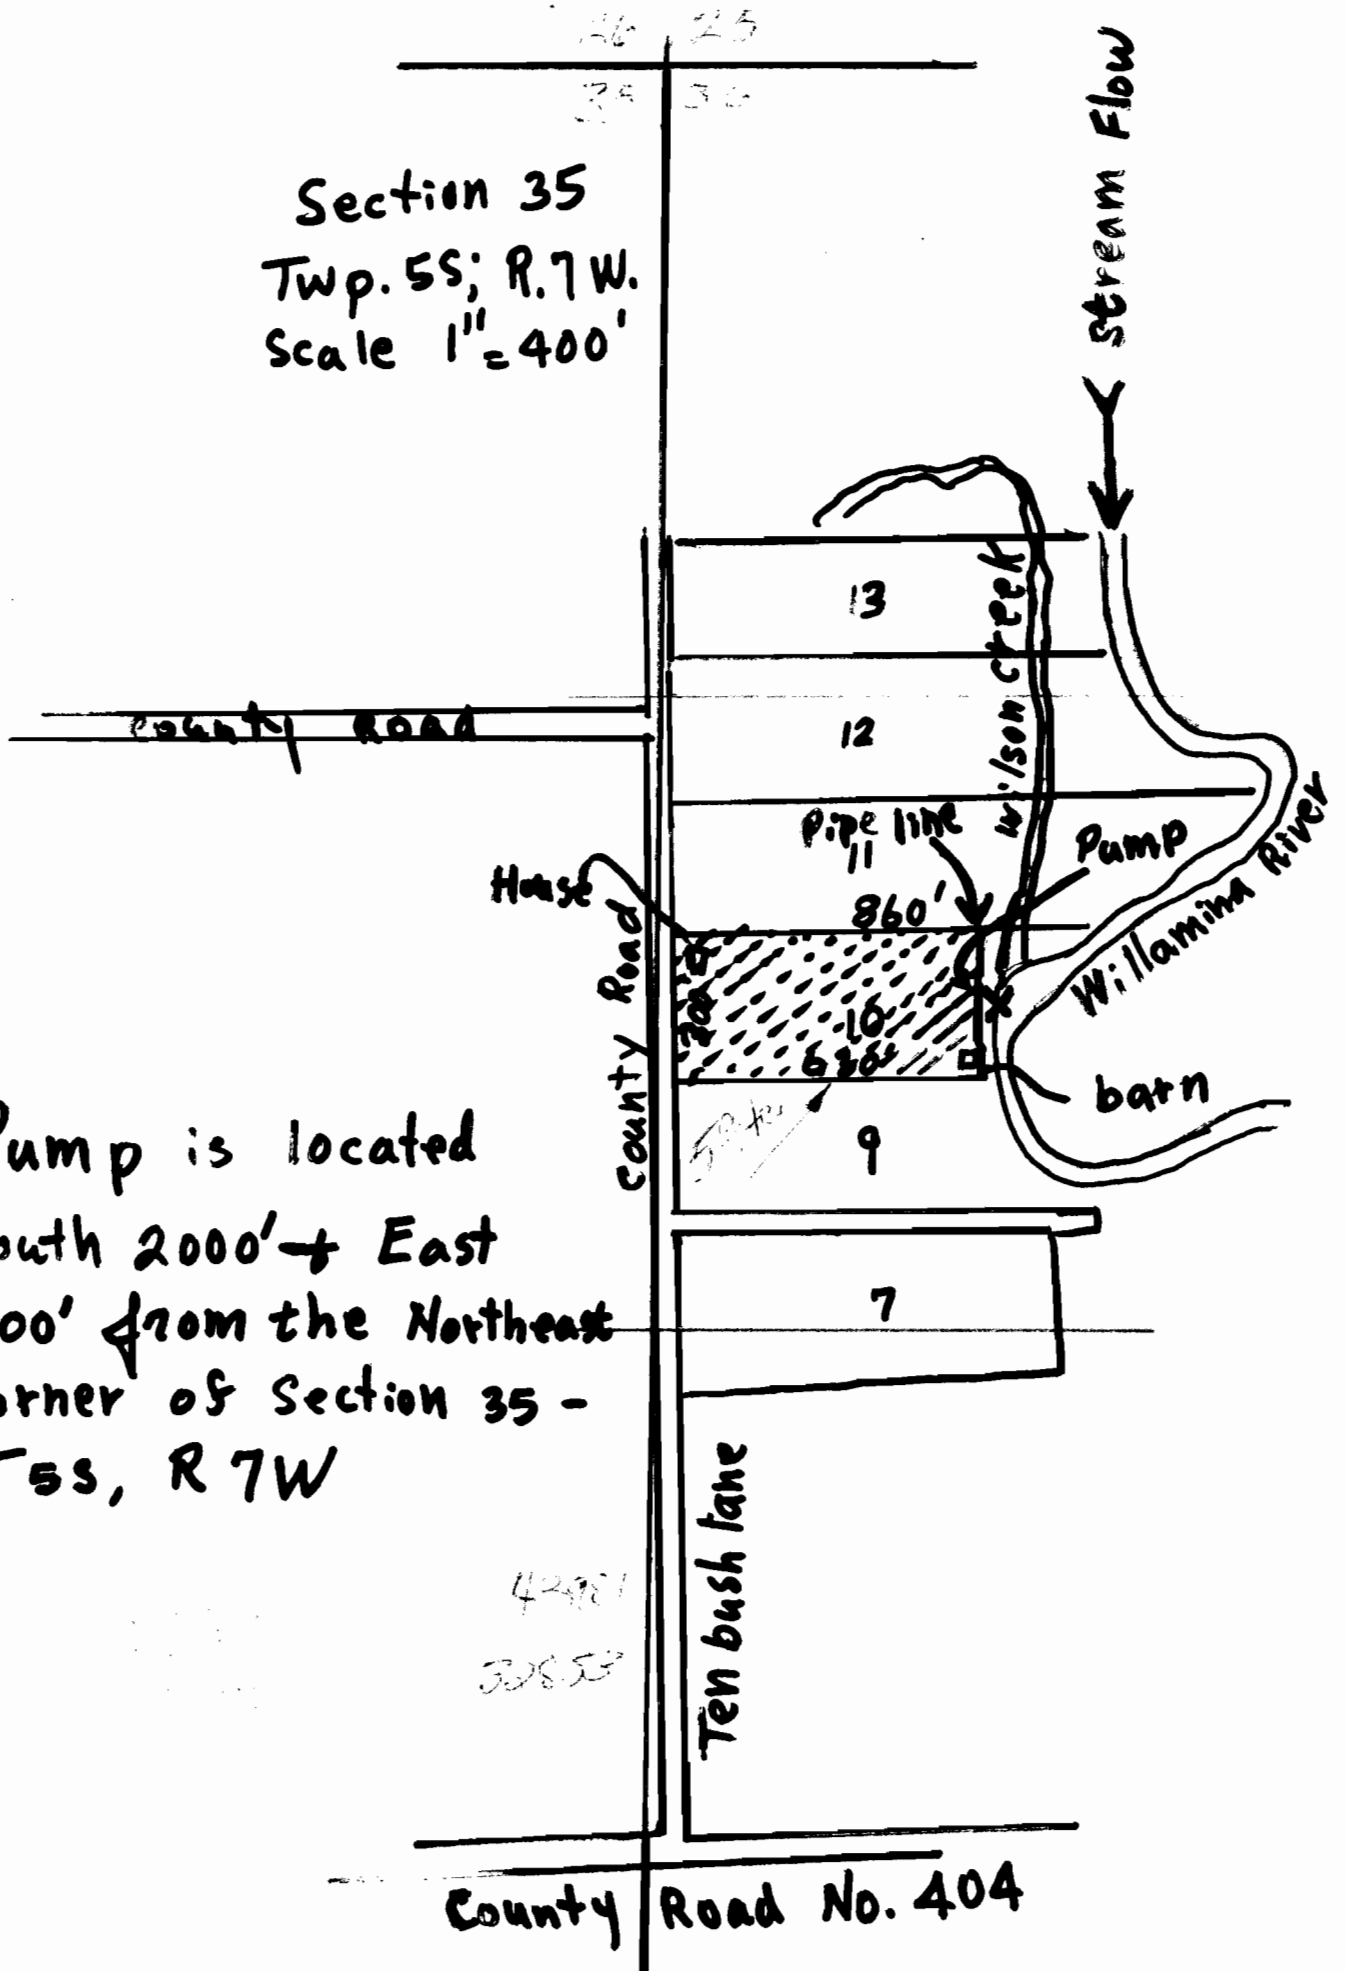

Pump is located  
 South 2000' + East  
 700' from the Northeast  
 corner of Section 35 -  
 T5S, R 7W