


T.36 S.R.7 W.W.M.

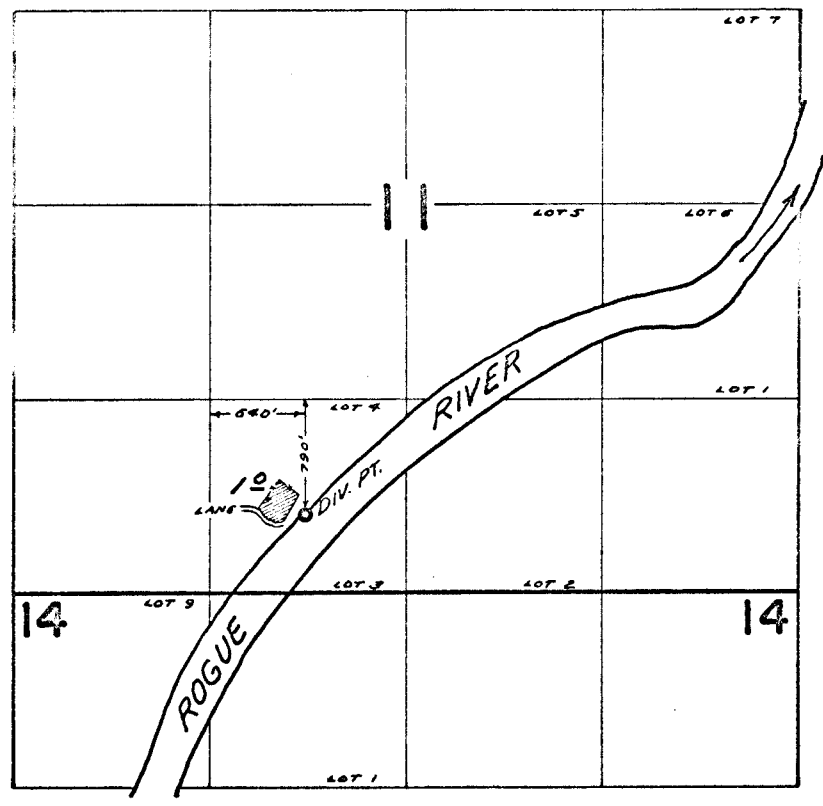

FINAL PROOF SURVEY UNDER

Application No. 44021 Permit No. 32904
IN NAME OF

EUGENE V. GOFF

Surveyed JUN 6 1969, by D. BUELL