


32924

T.36S.R.7W.W.M.

36-7-14

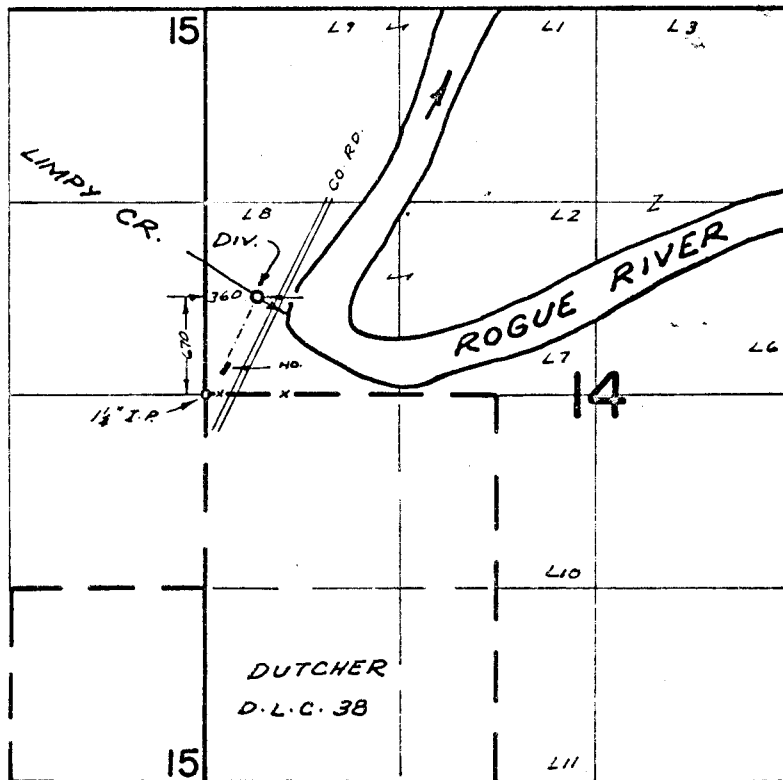

FINAL PROOF SURVEY
UNDER

Application No. 44061 Permit No. 32924
IN NAME OF

RICHARD D. SNELL

Surveyed APR. 19, 1972, by R. MUCKEN