


32942

T.40S.,R.8W.,W.M.

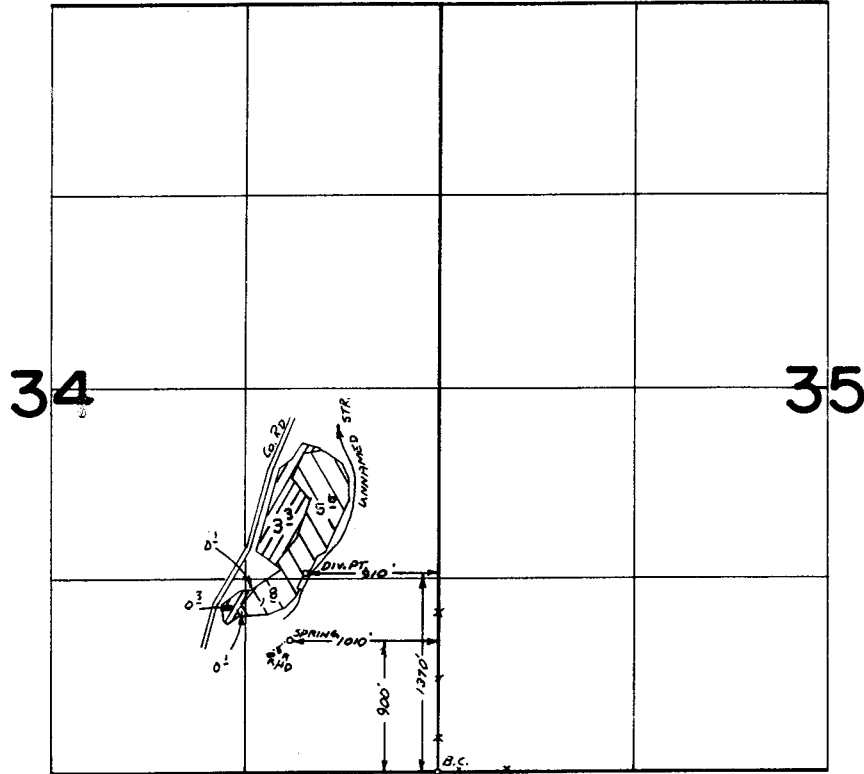

- PRIMARY

RECEIVED

JUN 21 1978

WM. DIST. 14  
GRANTS PASS, ORE.

**FINAL PROOF SURVEY**  
UNDER

Application No. 44097 Permit No. 32942  
46245 IN NAME OF 34550

GOLDEN V. MAYLONE

Surveyed MAY 2 1975, by L. Tall