


Per. #32945
T.36S.R.7W.W.M.

RECEIVED

DEC 13 1974

WM. DIST. 14
GRANTS PASS, ORE

36-7-22

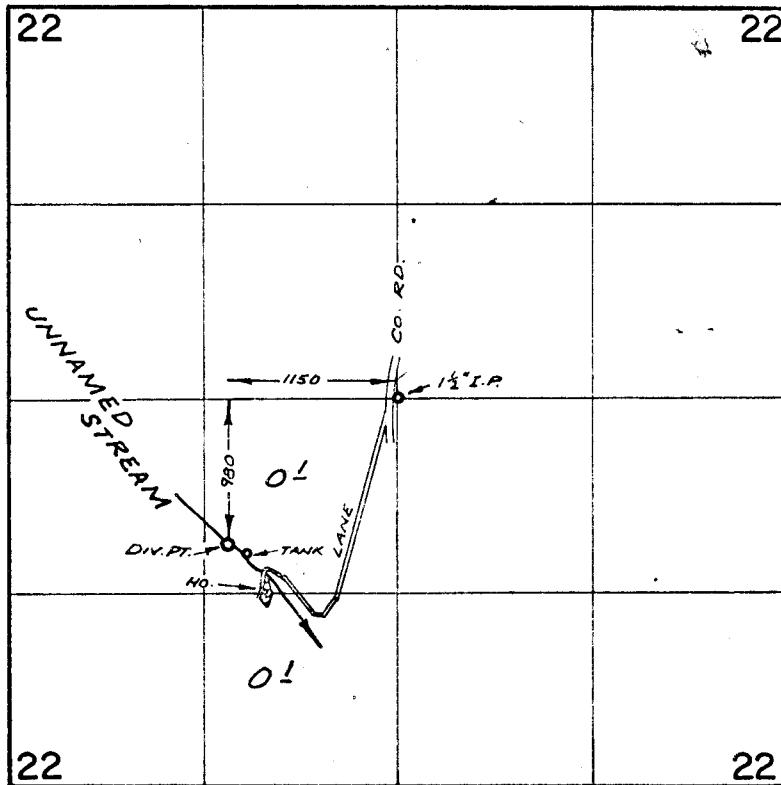

FINAL PROOF SURVEY
UNDER

Application No. 44101 Permit No. 32945
IN NAME OF

STEVEN A. MC SHANE

Surveyed APR. 21, 1972, by R. MUGKEN