


33105

T.40S.,R.8W.,W.M.

410-411

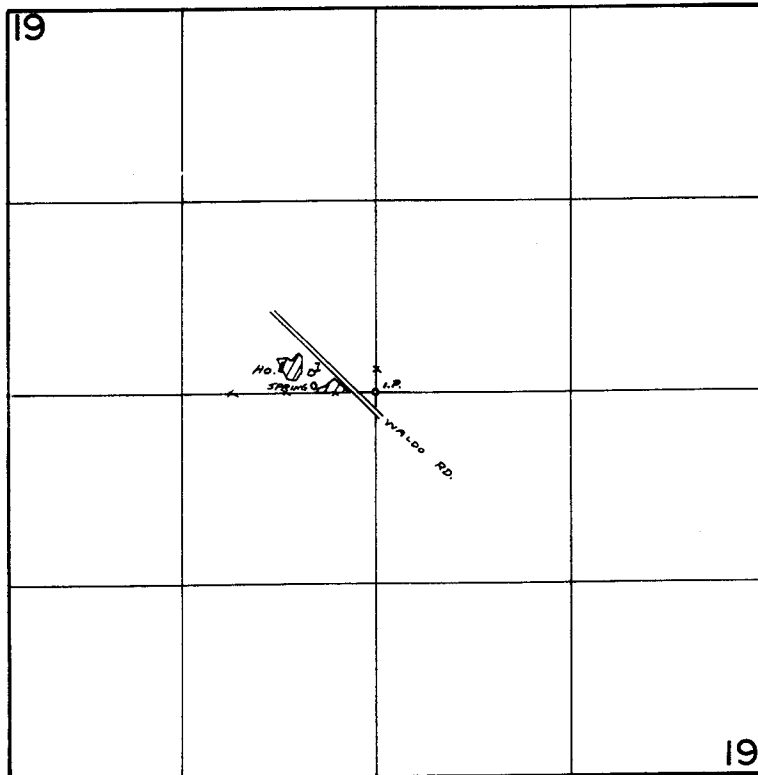

SPRING LOC: 60' N AND 420' W FROM CENTER SEC 19

RECEIVED

JUN 21 1978

WM. DIST. 14
GRANTS PASS. ORE

**FINAL PROOF SURVEY
UNDER**

Application No. 44331 Permit No. 33105
IN NAME OF

VERNON EDWARD & JESSIE M. NUNEMAKER

Surveyed APRIL 30 1975, by L. Toll