


T.35S.R.7W.W.M.

RECEIVED

DEC 13 1974

WM. DIST. 14  
GRANTS PASS, ORE.

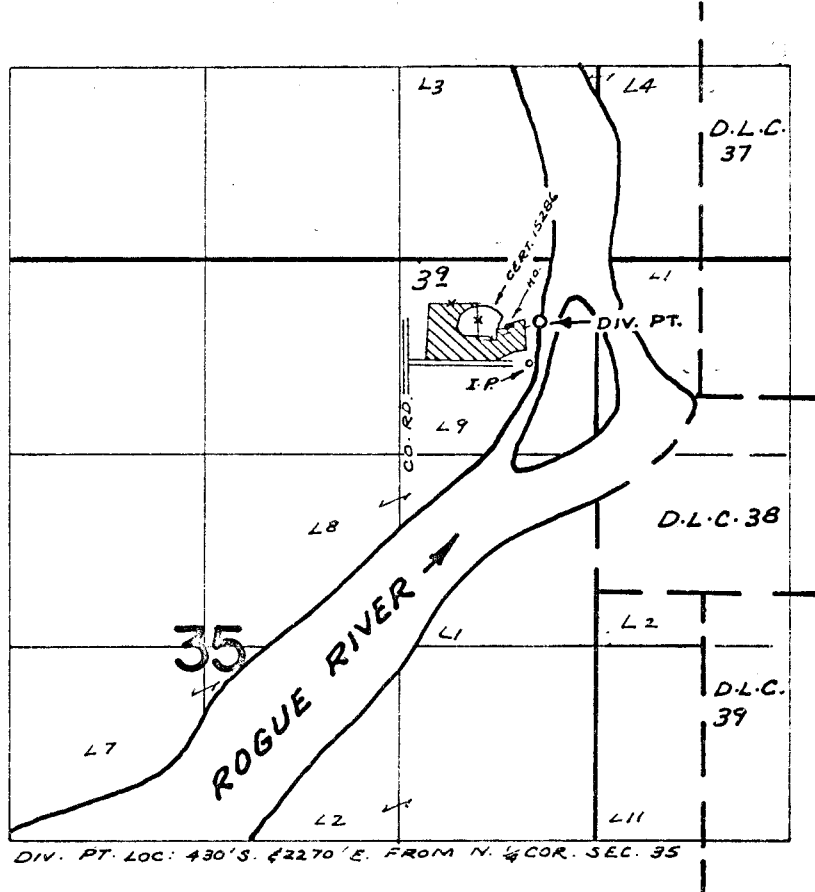

FINAL PROOF SURVEY  
UNDER

Application No. 44353 Permit No. 33114  
IN NAME OF

WESLEY E. & BETTY L. HOKENG

Surveyed APR. 18, 1972, by R. MUCKEN