


PLAT OF PUMP SITE - NOT A SURVEY  
 RALF N. HAKANSON  
 SEC 1, T25S R4W  
 SCALE 4"=1 MILE JANUARY 26, 1968

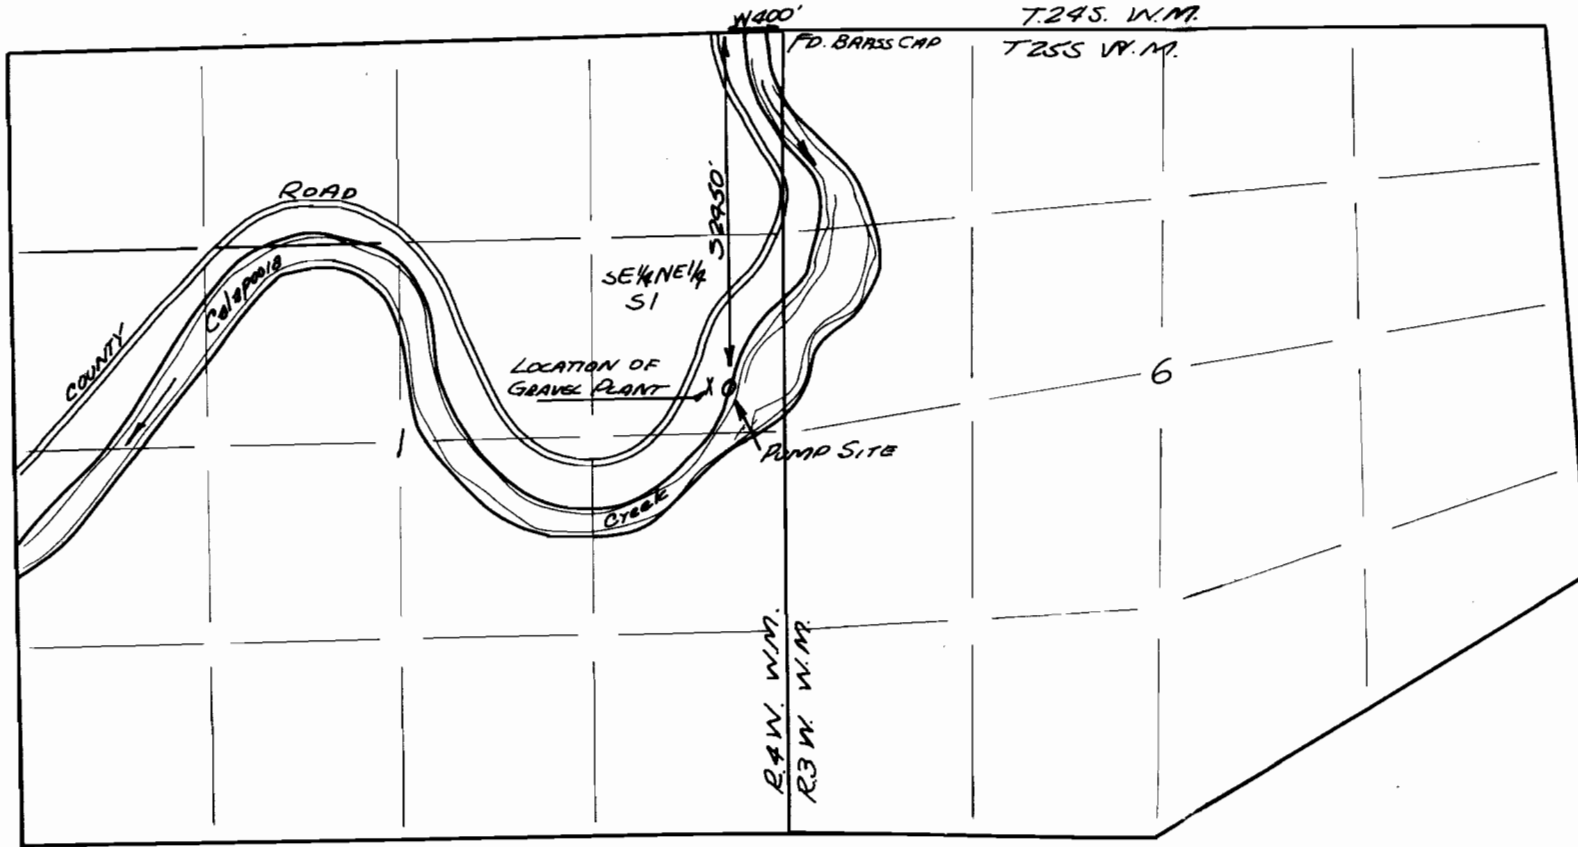

REGISTERED  
 OREGON  
 LAND SURVEYOR

*Malcolm N. Clark*

JULY 12, 1963  
 MALCOLM N. CLARK  
 601

RECEIVED  
 JUL 28 1968

STATE ENGINEER  
 OREGON DIVISION

Application No. 45213  
 Permit No. 33015