


~~R-5294~~ / R-5290
~~33494~~ / 33494
 36-6-24

T.36 S. R.6 W. W.M.

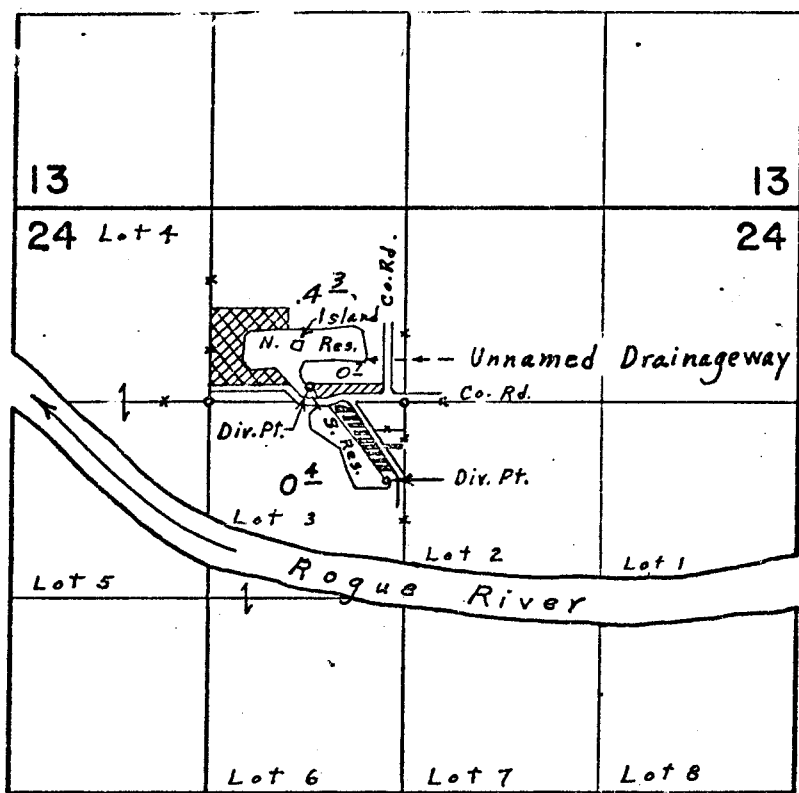

Div. Pts. loc.: N. Res., 100' N. & 630' W.; S. Res., 530' S. & 120' W.,
 both from S.E. Cor. N.E. $\frac{1}{4}$ N.W. $\frac{1}{4}$ Sec. 24

**FINAL PROOF SURVEY
 UNDER**

R-45466 R-5372
 45420 33905
 R-43698 R-5290
 Application No. 43698 Permit No. 33494
 IN NAME OF
CONSOLIDATED PIPELINE CO., INC.

Surveyed April 24 1974, by L.E. Gould

RECEIVED
 DEC 15 1982
 WM. DIST. 14
 GRANTS PASS, ORE