


T. 1 N. R. 3 W. W. M.

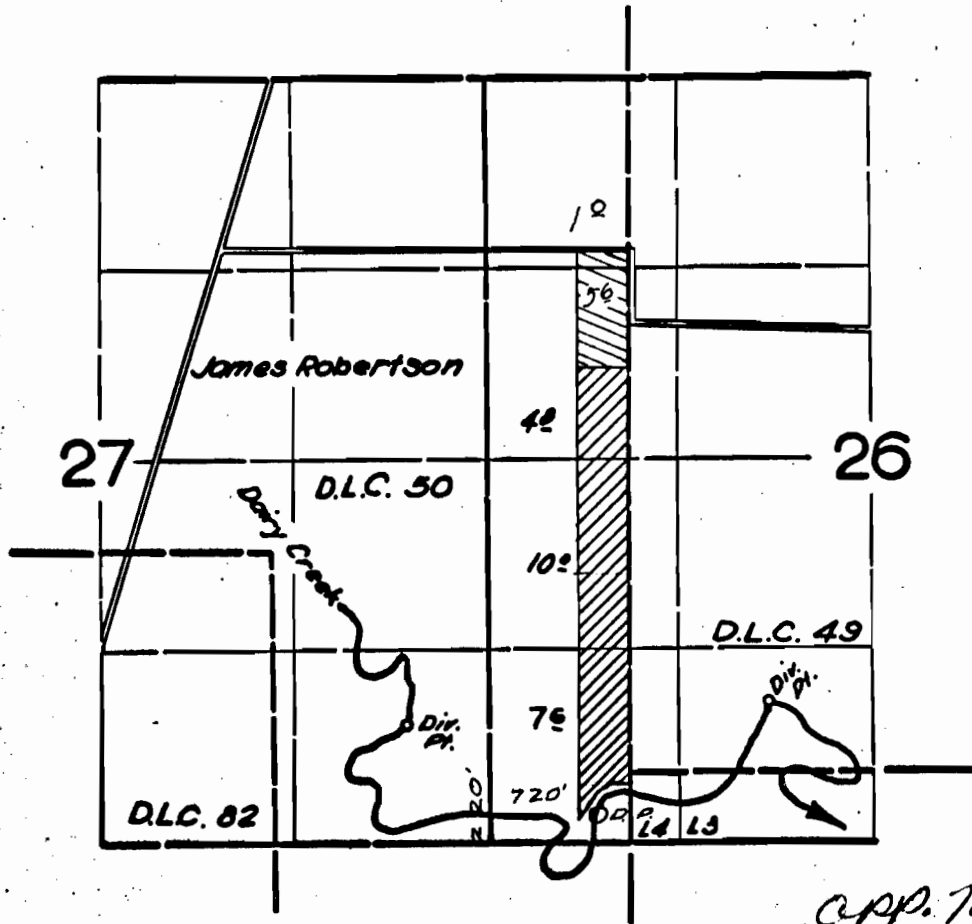

app. 720, 44816
Per. 720, 33519

FINAL PROOF SURVEY UNDER

IN NAME OF

.....
CECIL N. KINDEL
.....

Surveyed 26 May 1959, by *R. Jackson*