


33656

T. 35 S.R. 7 W. W.M.

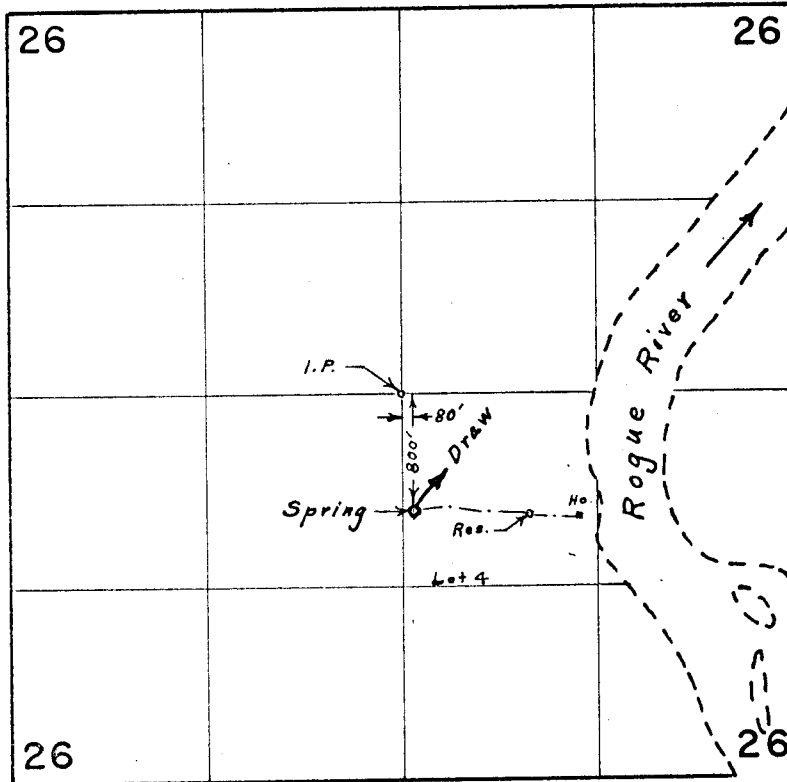

FINAL PROOF SURVEY

UNDER

Application No. 45030 Permit No. 33656

IN NAME OF

EDWIN S. CRAM

Surveyed April 27, 1970, by L. E. Gould.