


EASEMENT // R/W AGREEMENT
 OTHER (SPECIFY) FOR WATER STORAGE & 9" PIPE LINE

TWP 4 N RANGE 9 W
 DIVISION CLATSOP
 COUNTY CLATSOP STATE OREGON

SEC 28
 SCALE 1" = 500'
 DATE 9-3-65

By EW
 APPROVED [Signature]

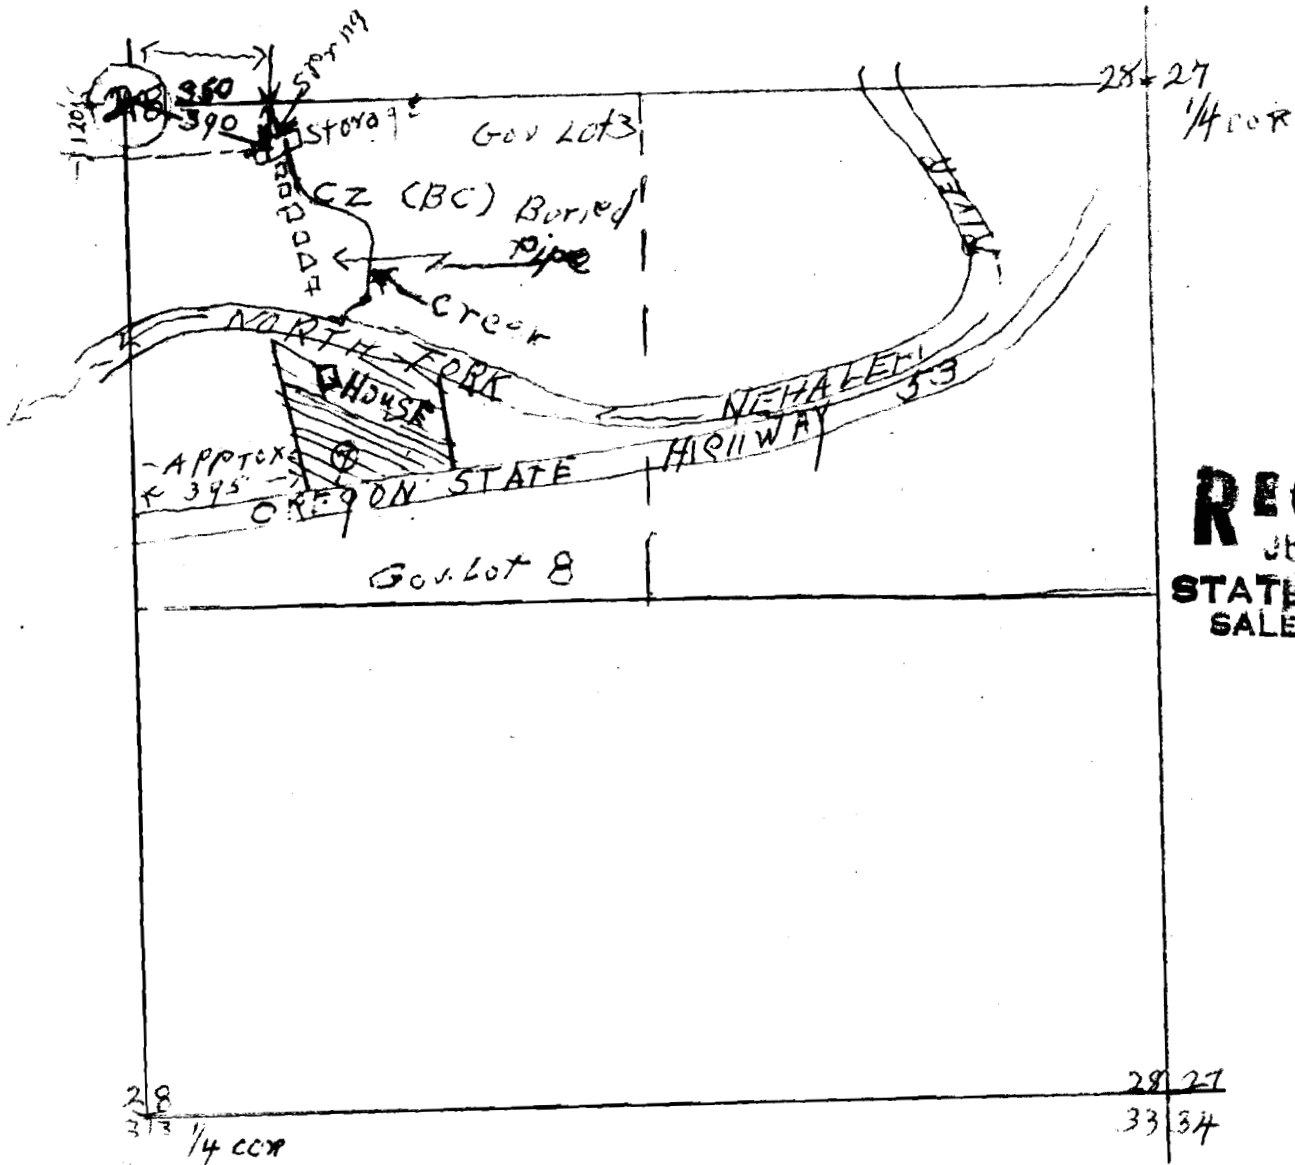

RECEIVED
 JUN 19 1968
 STATE ENGINEER
 SALEM, OREGON

"EXHIBIT A"

EXHIBIT A

Application No. 45081
 Permit No. 33694

REMARKS With Irene and R.S. NACAULAY

LEGEND
 APPROX C - Expln
 PIPE R/W
 STORAGE