


FREDRICK HELMS DLC 60

T. 35. R4E
Sec 29

N1/4 NE cor.
lot 6

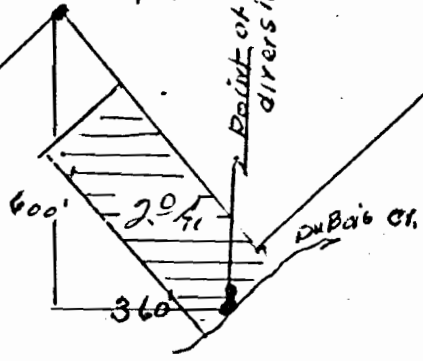


Scale = 1" = 400'

Application No. 45090
Permit No. 37698

RECEIVED

MAY 22 1968

STATE ENGINEER
SALEM OREGON

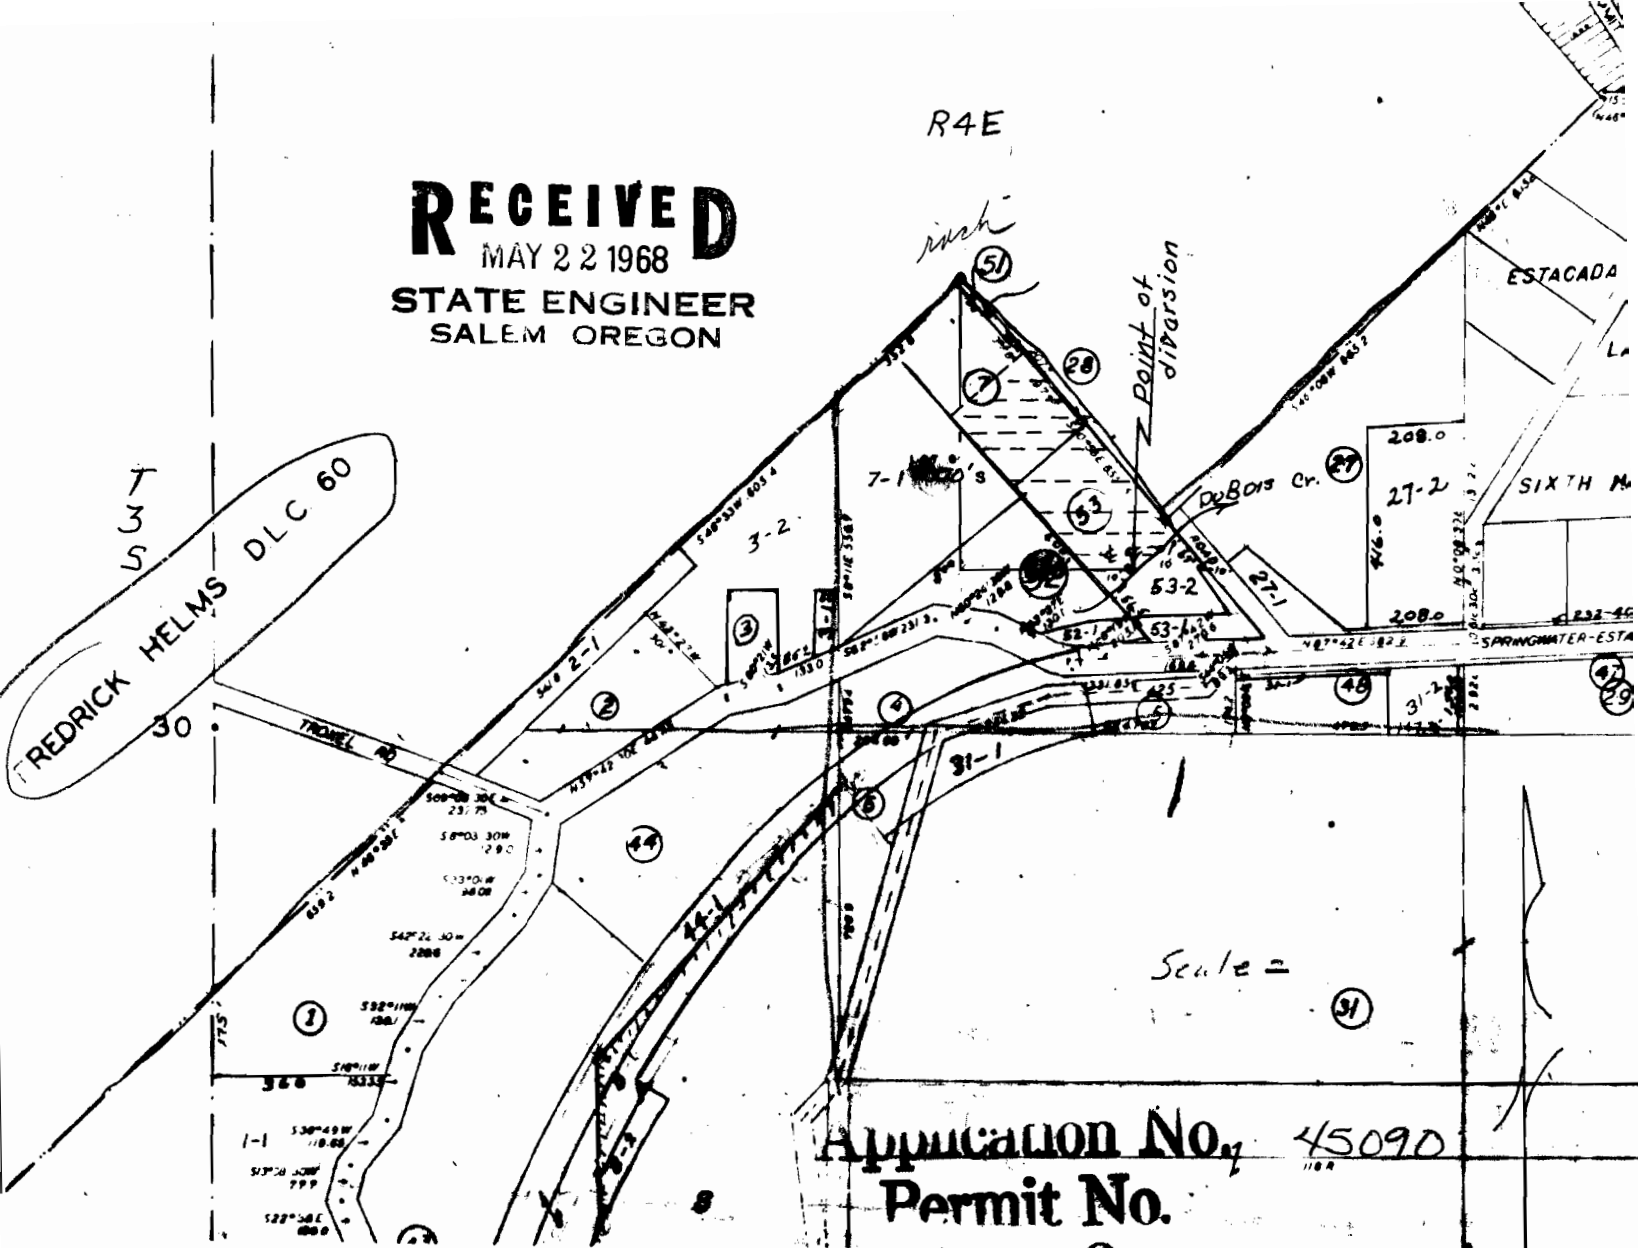

R4E

inch


FREDRICK HELMS DLC 60

Scale = 1" = 100'

Application No. 45090
Permit No.