


RECEIVED
 JUN 18 1968
 STATE ENGINEER
 CALIFORNIA

T.32 S. R.3E. W.M.

SCALE 1" = 400'

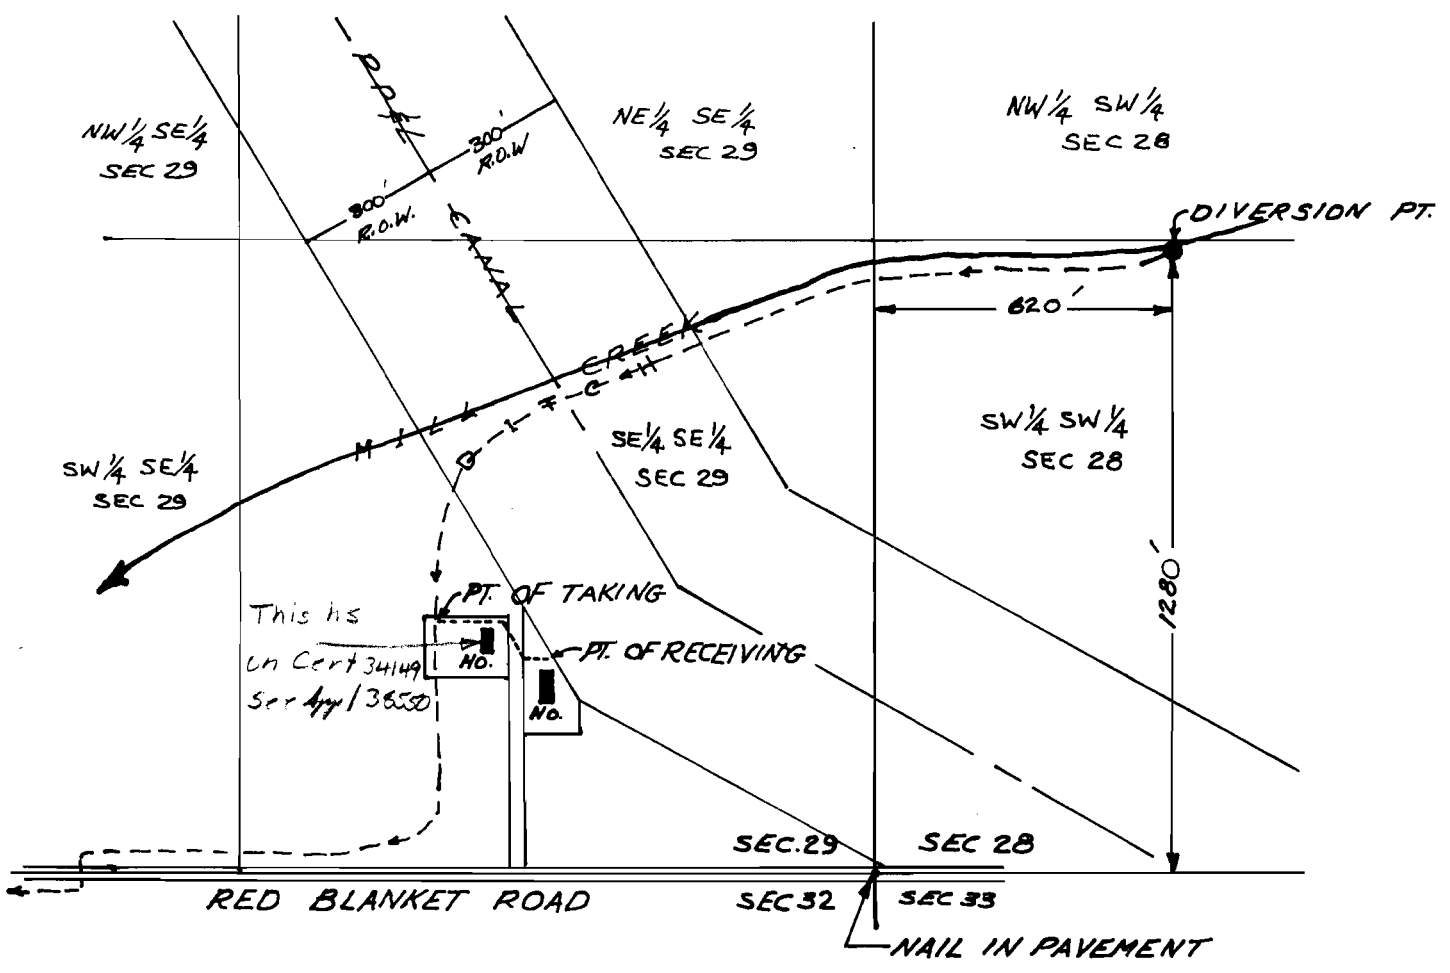

APPLICATION NO. 45146
 Permit No. 33729