

33730


T.37S.,R.5W.,W.M.

RECEIVED

NOV 24 1976

WM. DIST. 14
GRANTS PASS, ORE.

37221

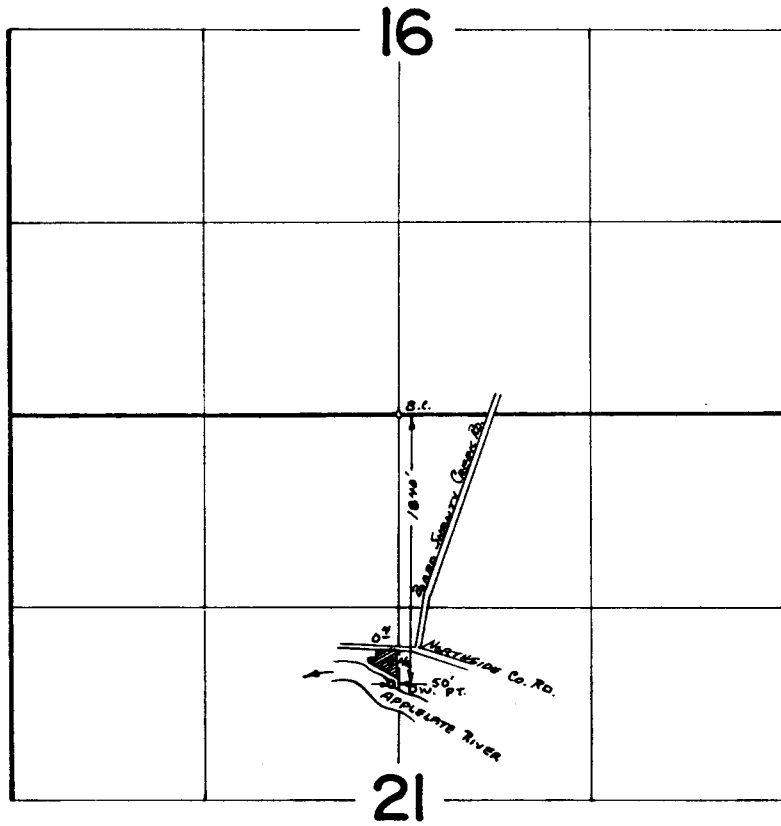

FINAL PROOF SURVEY
UNDER

Application No. 45147 Permit No. 33730
IN NAME OF

WAYNE G. HAW

Surveyed Oct. 3 1974, by L. Toll