


MAP

SCALE = 1" = 300'

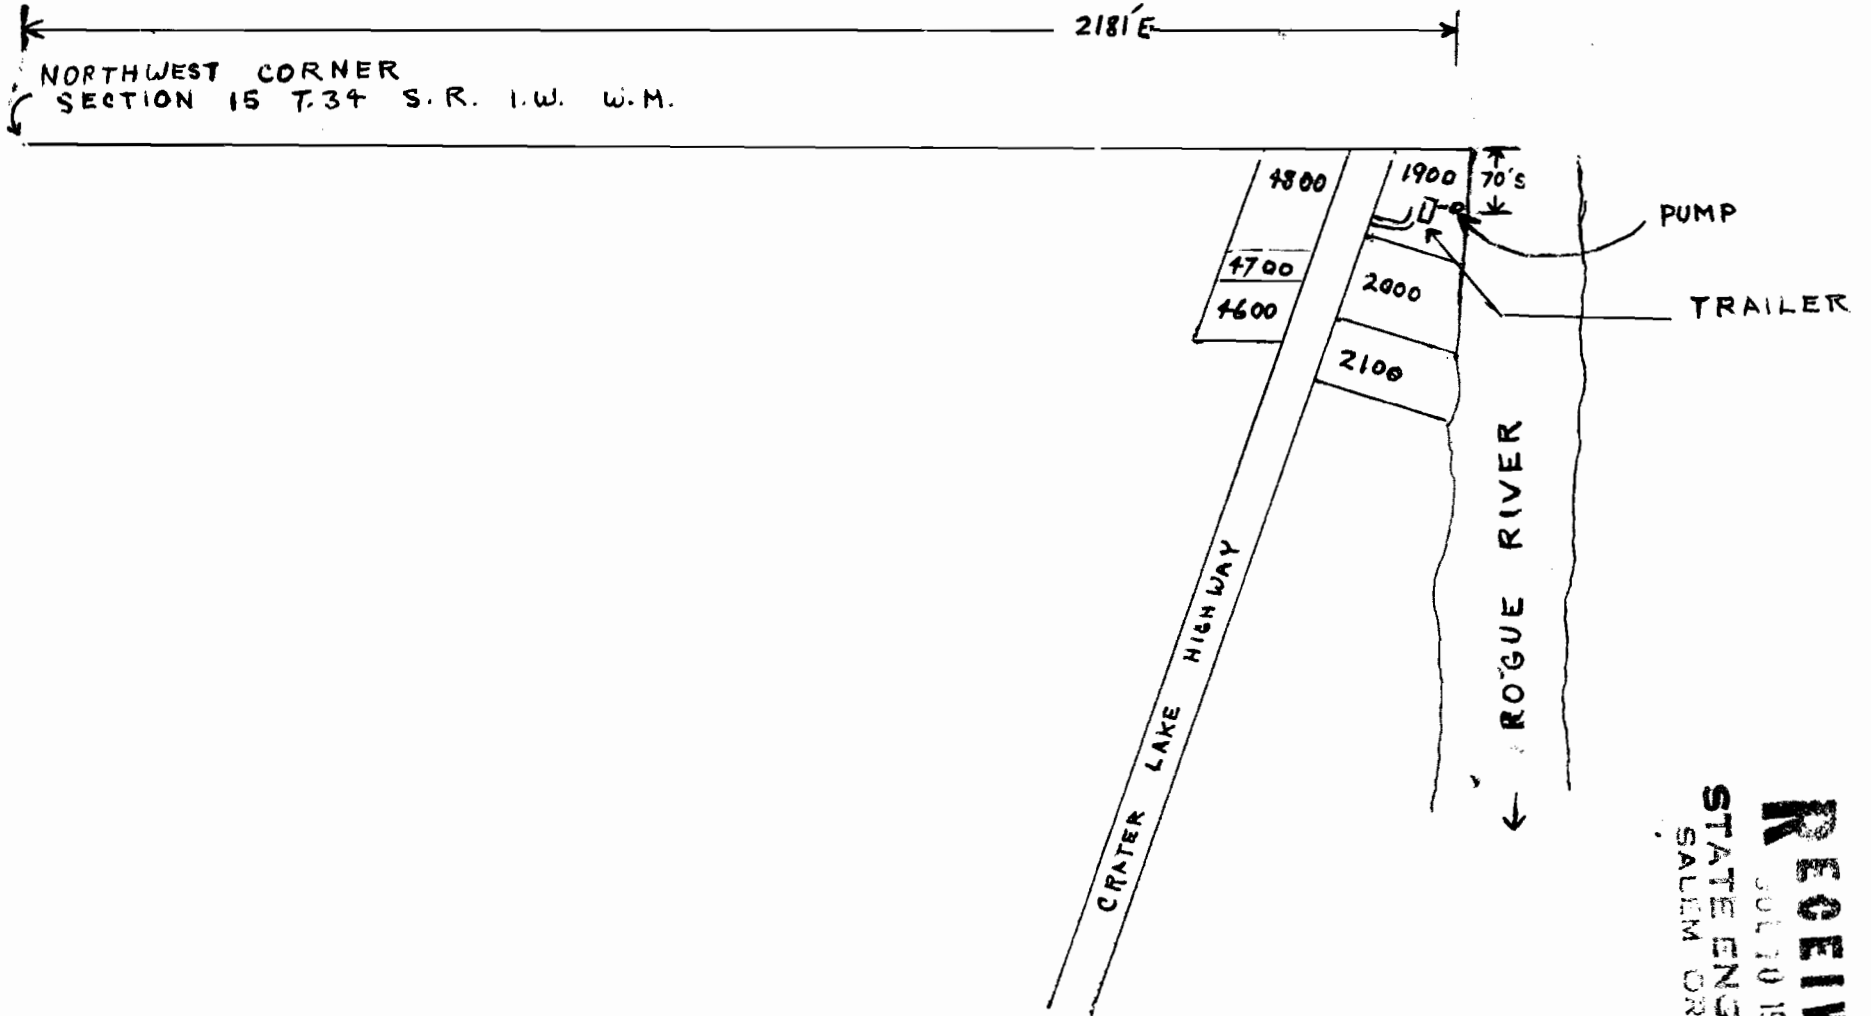

APPROVAL NO. 45161  
Permit No. 33741

**RECEIVED**  
JUL 30 1968  
STATE ENGINEER  
SALEM OREGON