

33776


31-8

T.37S.,R.9W.,W.M.

RECEIVED

NOV 24 1976

WM. DIST. 14  
GRANTS PASS, ORE.

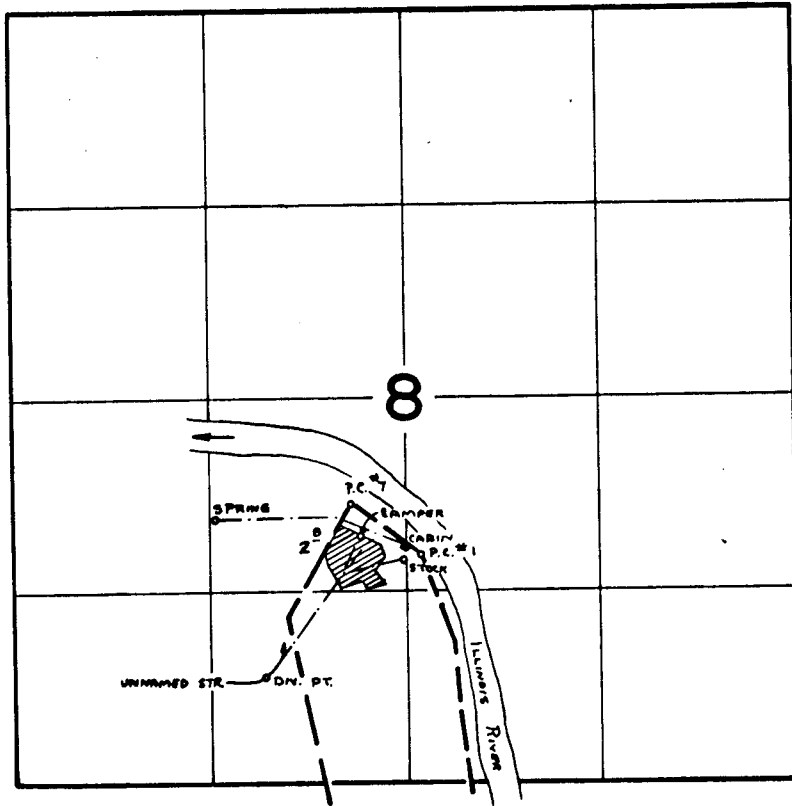

SPRING (A-45216) - 100' S AND 900' W FROM PROB COR. #7  
 STREAM (A-52266) - 500' W AND 1180' S. FROM PROB. COR. #7

**FINAL PROOF SURVEY**  
 UNDER

Application No. 52266 / 45216 Permit No. 33776  
 IN NAME OF

DOLORIS LLOYD

Surveyed SEPT. 19. 1974, by L. TALL