


33807

T.37S. R.7W. W.M.

37-7-18

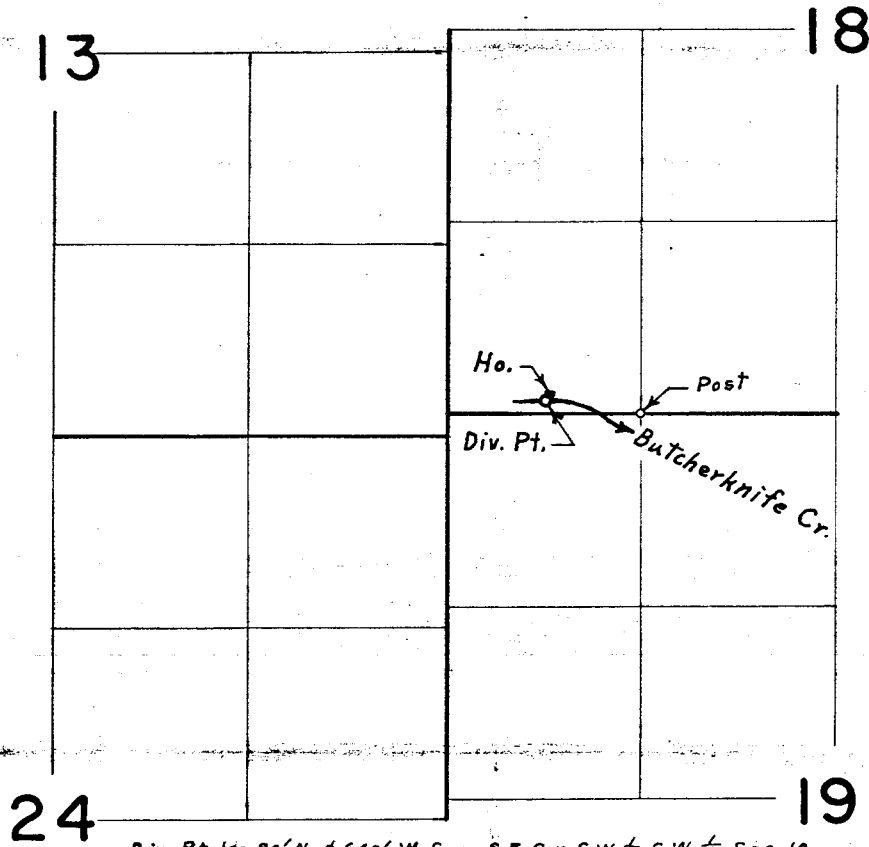

Div. Pt. 100.80' N. & 640' W. from S.E. Cor. S.W. $\frac{1}{4}$ S.W. $\frac{1}{4}$ Sec. 18

RECEIVED

JUN 5 1978

WM. DIST. 14
GRANTS PASS, ORE

FINAL PROOF SURVEY
UNDER

Application No. 45269 Permit No. 33807
IN NAME OF

MARVIN D. SPRINKLE

Surveyed Sept. 18, 1975, by L. E. Gould