


T. 35 S., R. 6 W., W.M.

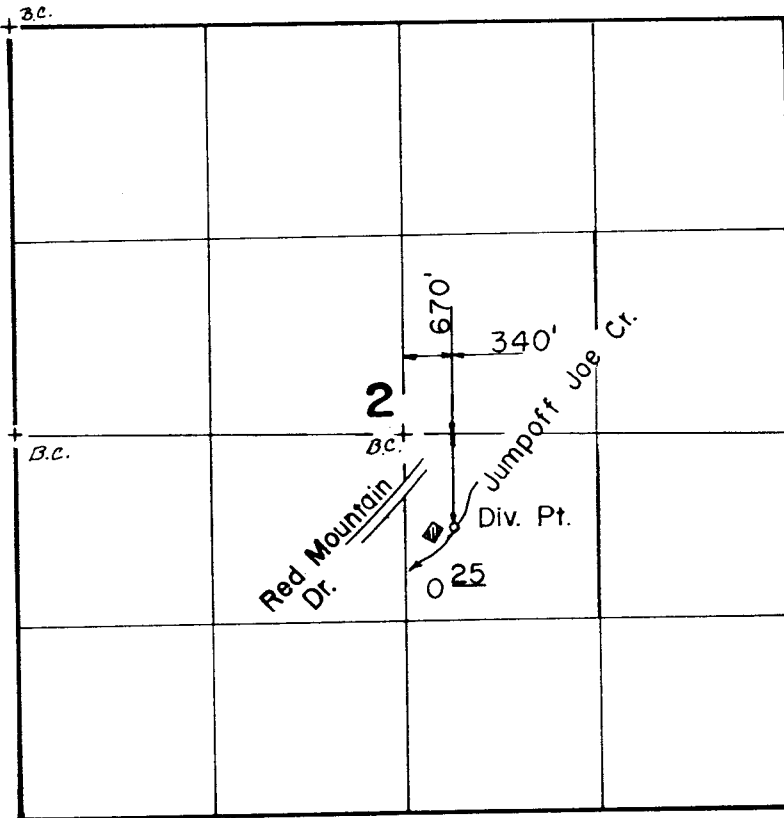

Scale: 1" = 1320'

**FINAL PROOF SURVEY**  
UNDER

Application No. 45277 Permit No. 33810....  
IN NAME OF

MR. & MRS. CHARLES L. SPAIN

Surveyed Sep. 24, 1987, by B. S. JAMES.