


R-5374 / ~~R-5270~~
33905 / ~~33404~~

36-6-24

T.36 S. R.6 W. W.M.

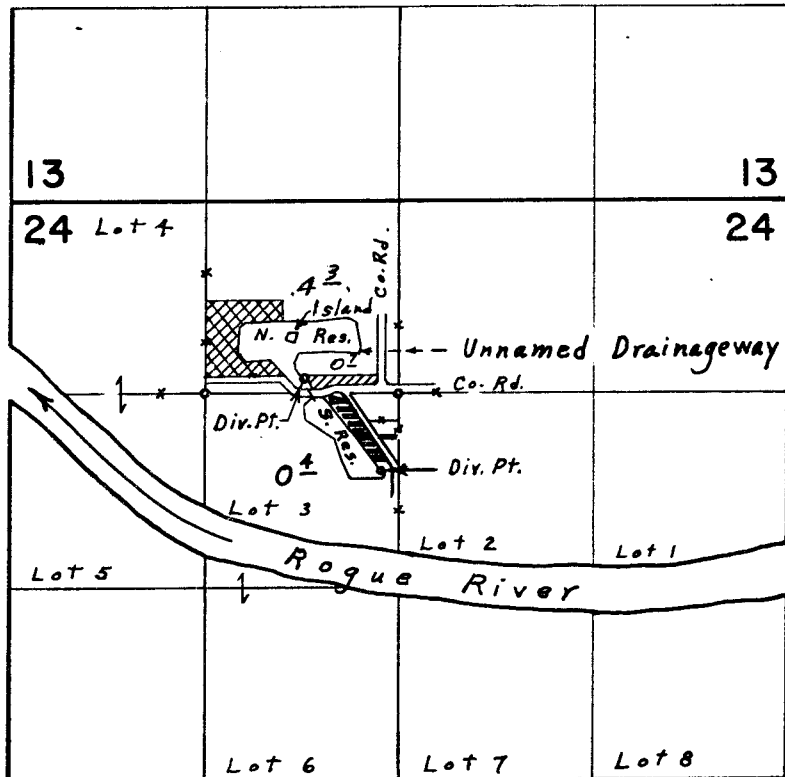

Div. Pts. loc.: N. Res., 100' N. & 630' W.; S. Res., 530' S. & 120' W.,
both from S.E. Cor. N.E. $\frac{1}{4}$ N.W. $\frac{1}{4}$ Sec. 24

**FINAL PROOF SURVEY
UNDER**

R-45466 R-5374
45420 33905
R-43698 R-5290
Application No. 43699 Permit No. 33494
IN NAME OF
CONSOLIDATED PIPELINE CO., INC.

Surveyed April 24 1974, by L. E. Gould

RECEIVED

DEC 15 1982

WM. DIST. 14
GRANTS PASS, OR