


T. 9 S. R. 1 & 2 W. W.M.

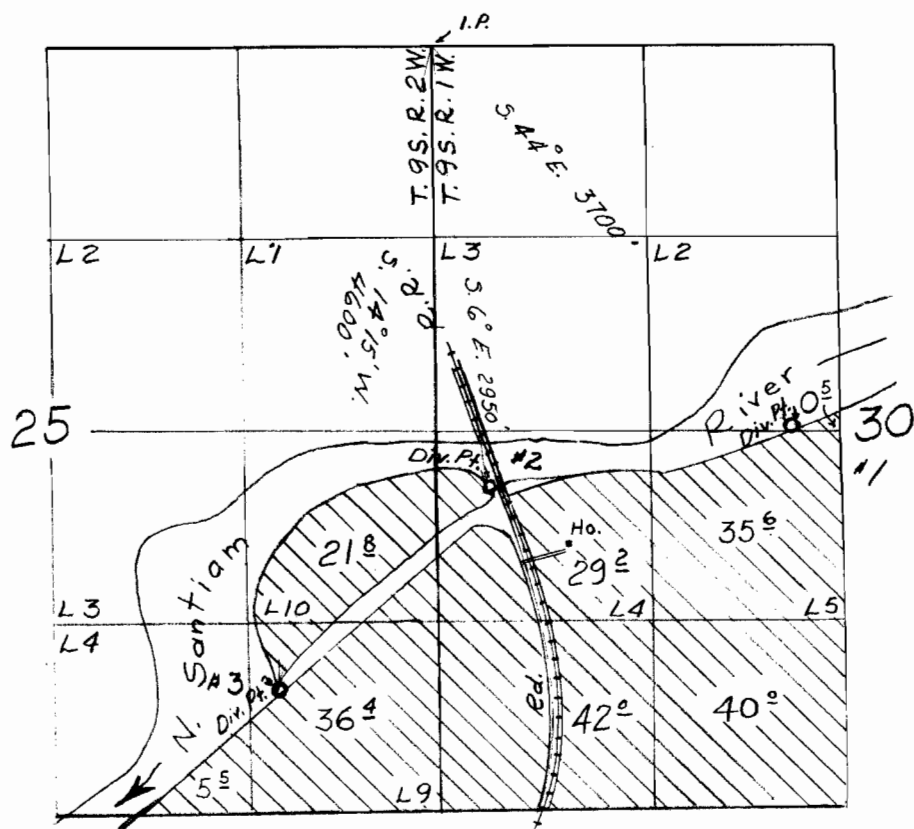

Henry Hess

Application No. 45437
Permit No. 33911

Application No. 32172
Permit No. 25382