


Scale 8" = 1 mile

RECEIVED
 NOV 22 1968
 STATE ENGINEER
 SALEM OREGON

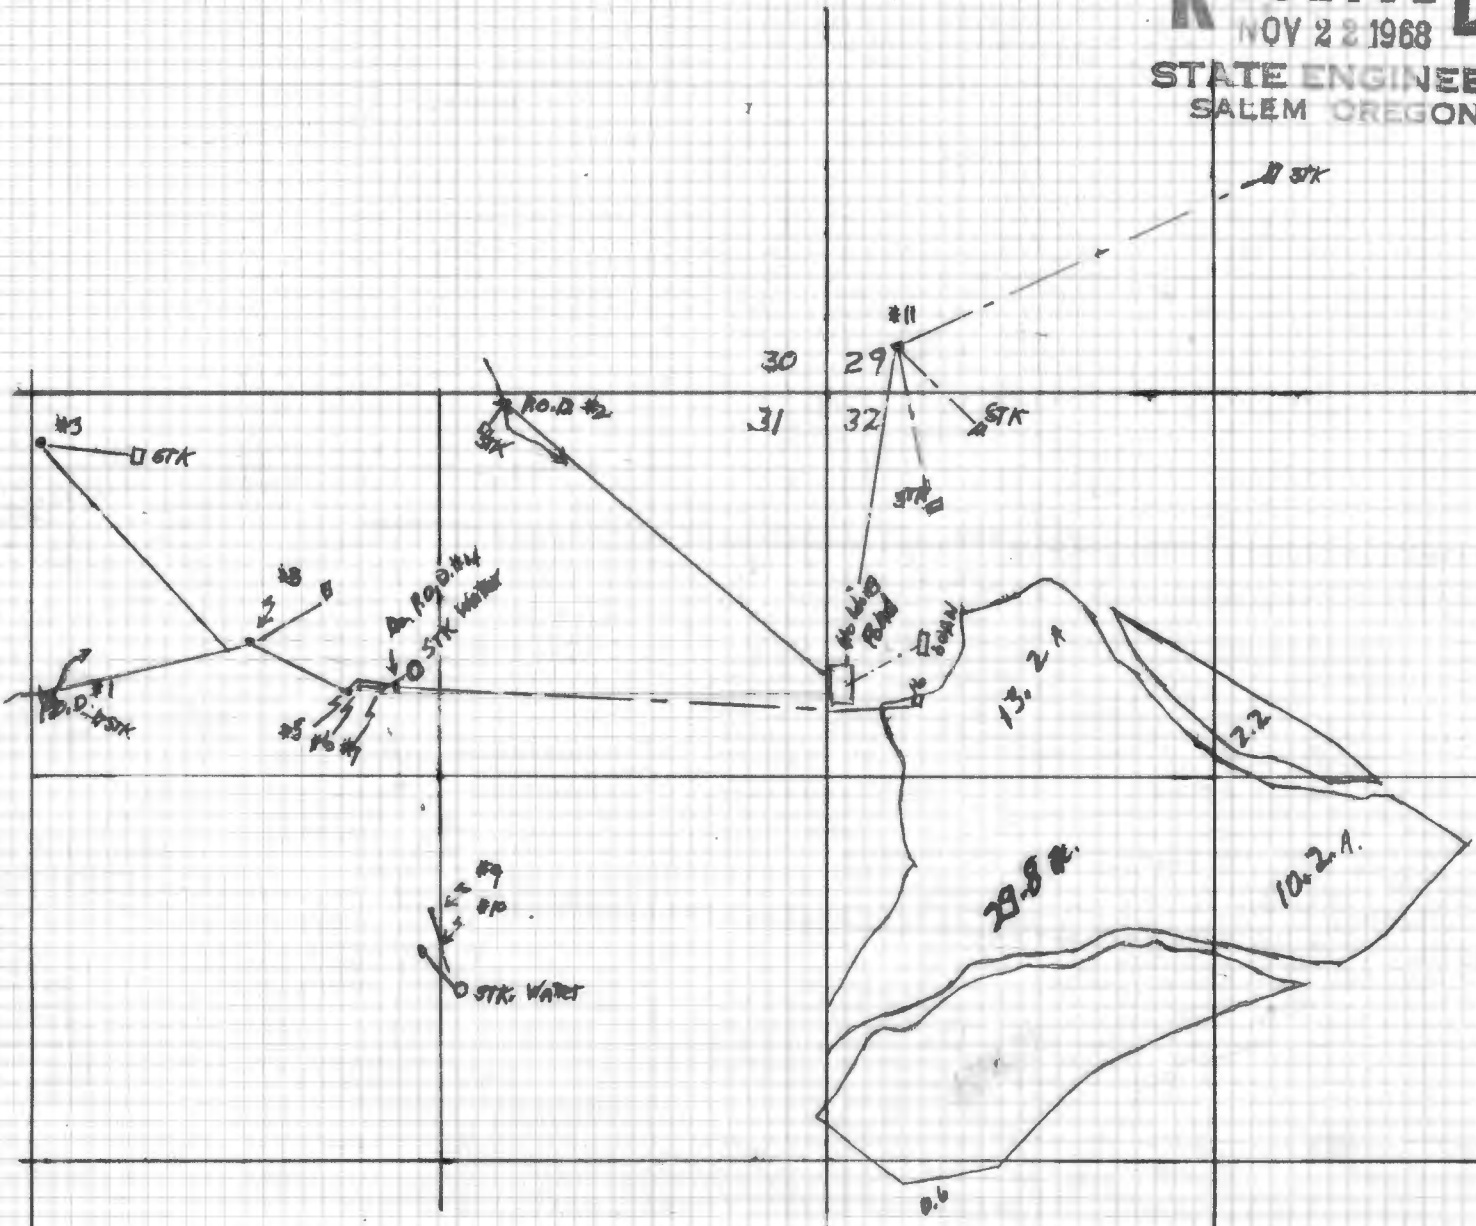

Source	Number	Feet N. or S.	Feet E. or W.	1/4 Section
Unn. str.	1	1040 feet south	2680 feet west	NW 1/4 NE 1/4 sec. 31
Unn. str.	2	35 feet south	1100 feet west	NE 1/4 NE 1/4 sec. 31
spring	3	180 feet south	2690 feet west	NW 1/4 NE 1/4 sec. 31
spring	4	1020 feet south	1470 feet west	NW 1/4 NE 1/4 sec. 31
spring	5	1030 feet south	1640 feet west	NW 1/4 NE 1/4 sec. 31
spring	6	1020 feet south	1600 feet west	NW 1/4 NE 1/4 sec. 31
spring	7	1030 feet south	1530 feet west	NW 1/4 NE 1/4 sec. 31
spring	8	860 feet south	1980 feet west	NW 1/4 NE 1/4 sec. 31
spring	9	1780 feet south	1360 feet west	SW 1/4 NE 1/4 sec. 31
spring	10	1930 feet south	1380 feet west	SW 1/4 NE 1/4 sec. 31
spring	11	160 feet north	240 feet east	SW 1/4 SW 1/4 sec. 29

All from corner common to section 29, 30, 31, and 32, Township 27 South, Range 7 West, W.M. Douglas County.

Application No. 45554
 Permit No. 33987