


Tillamook County

Sec 22 T.15. R 10 W. W.M.

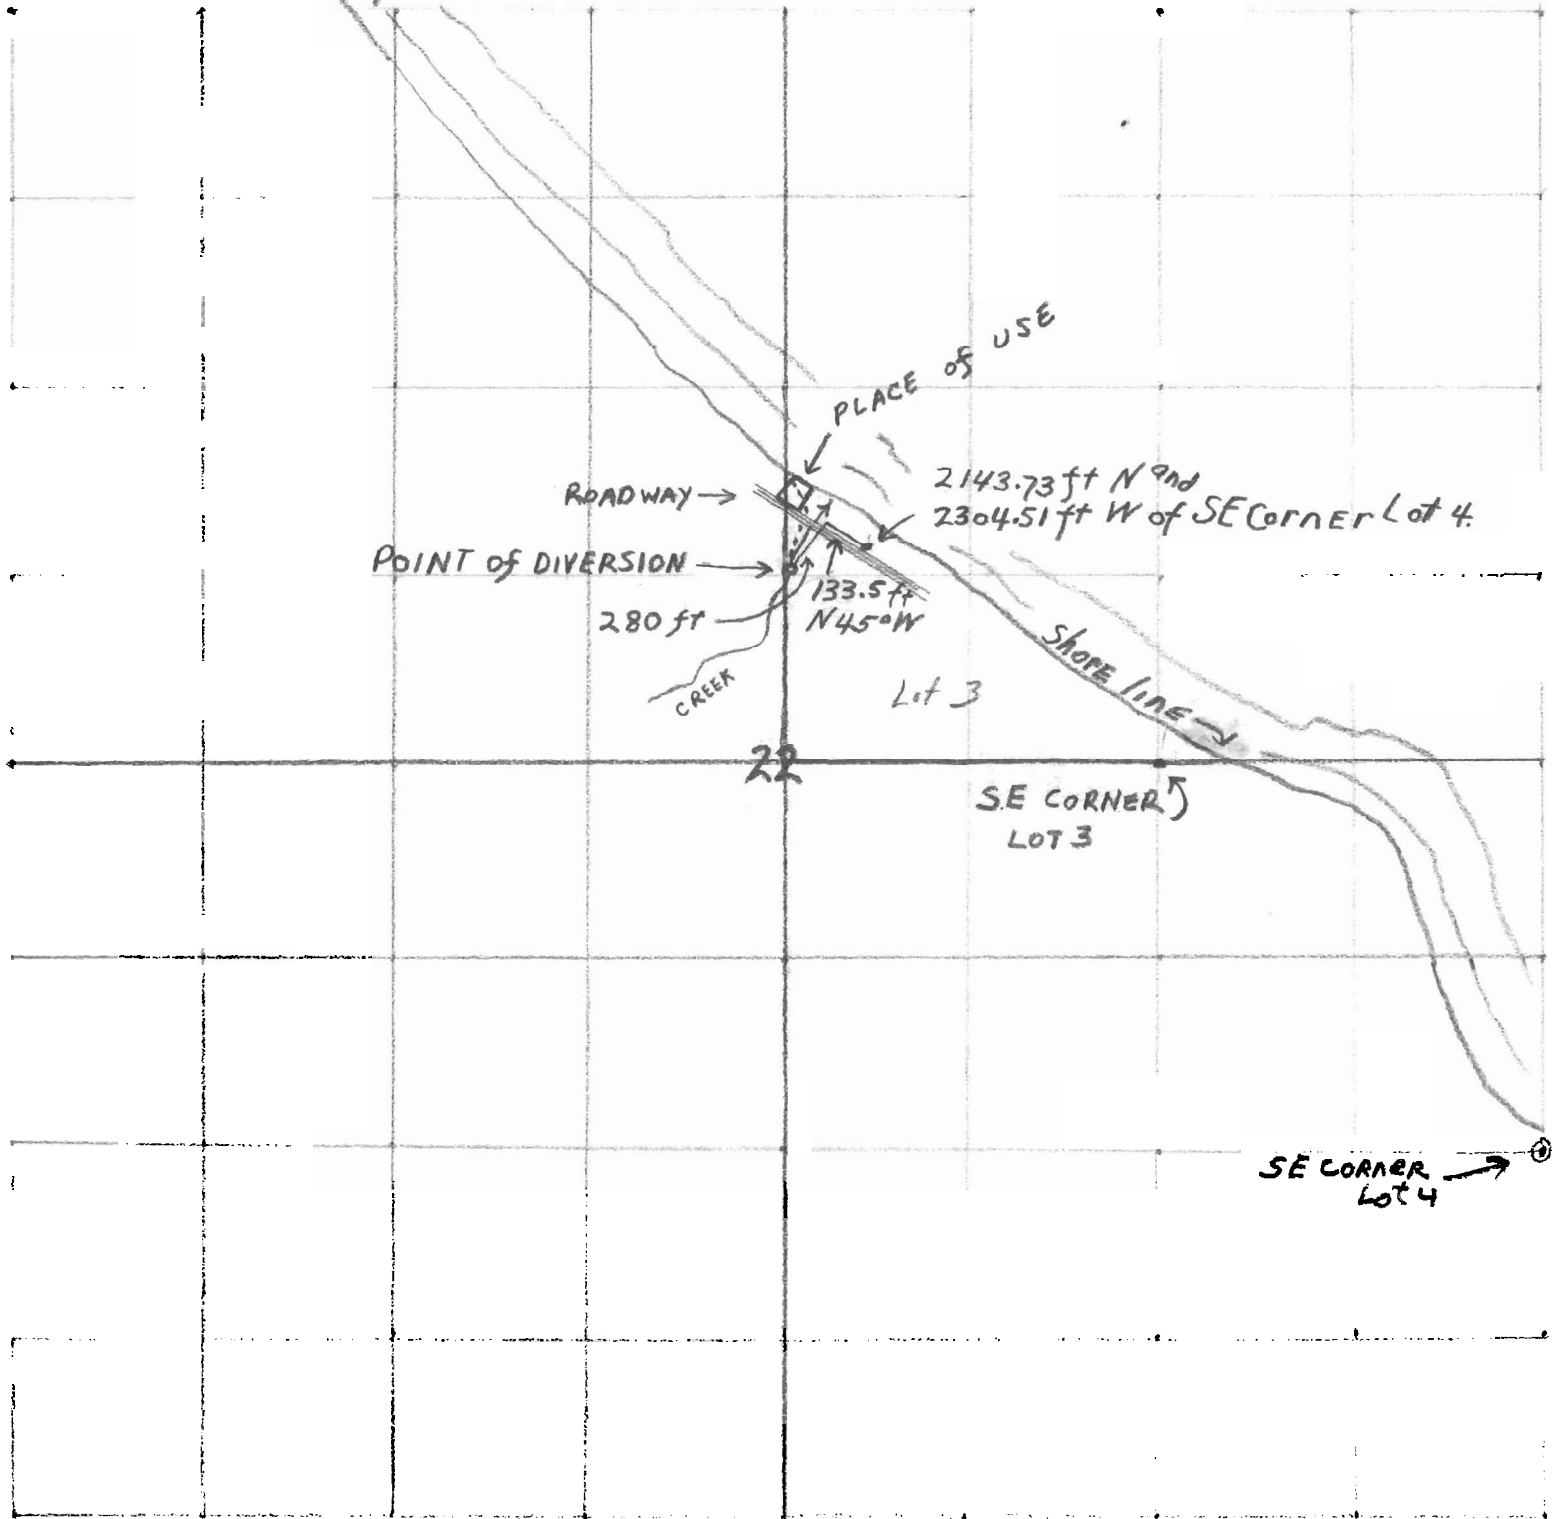

Proposed Water Right of JOSEPH M. SHATOS SR. 8"-1 Mile
Tillamook, Ore.

Application No. 45664
Permit No. 34052

RECEIVED
DEC 20 1968
STATE ENGINEER
SALEM OREGON