


34062 15

33-6-21

# T.33S.R.6W.W.M.

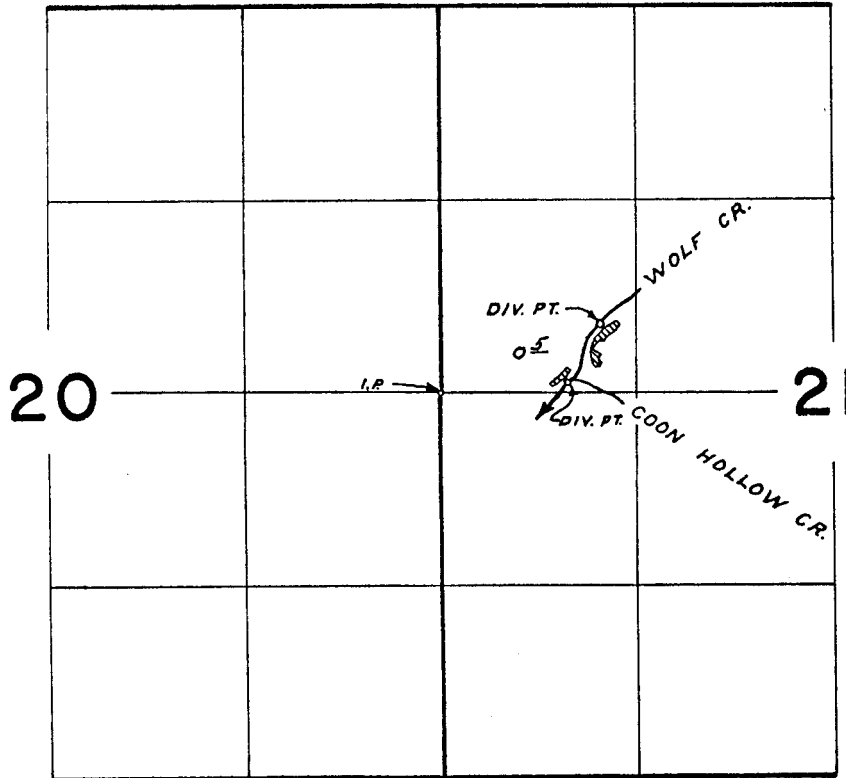

DIV. PTS. LOCATED:  $470' N + 10.70' E$  :  $60' N + 850' E$  :  
BOTH FROM THE  $W\frac{1}{4}$  CORNER SEC. 21

Application No. 45791  
Permit No. 34062