


DETAIL CONC. BOX  
SPILLWAY

**RECEIVED**  
OCT 1 1968  
STATE ENGINEER  
SALEM, OREGON

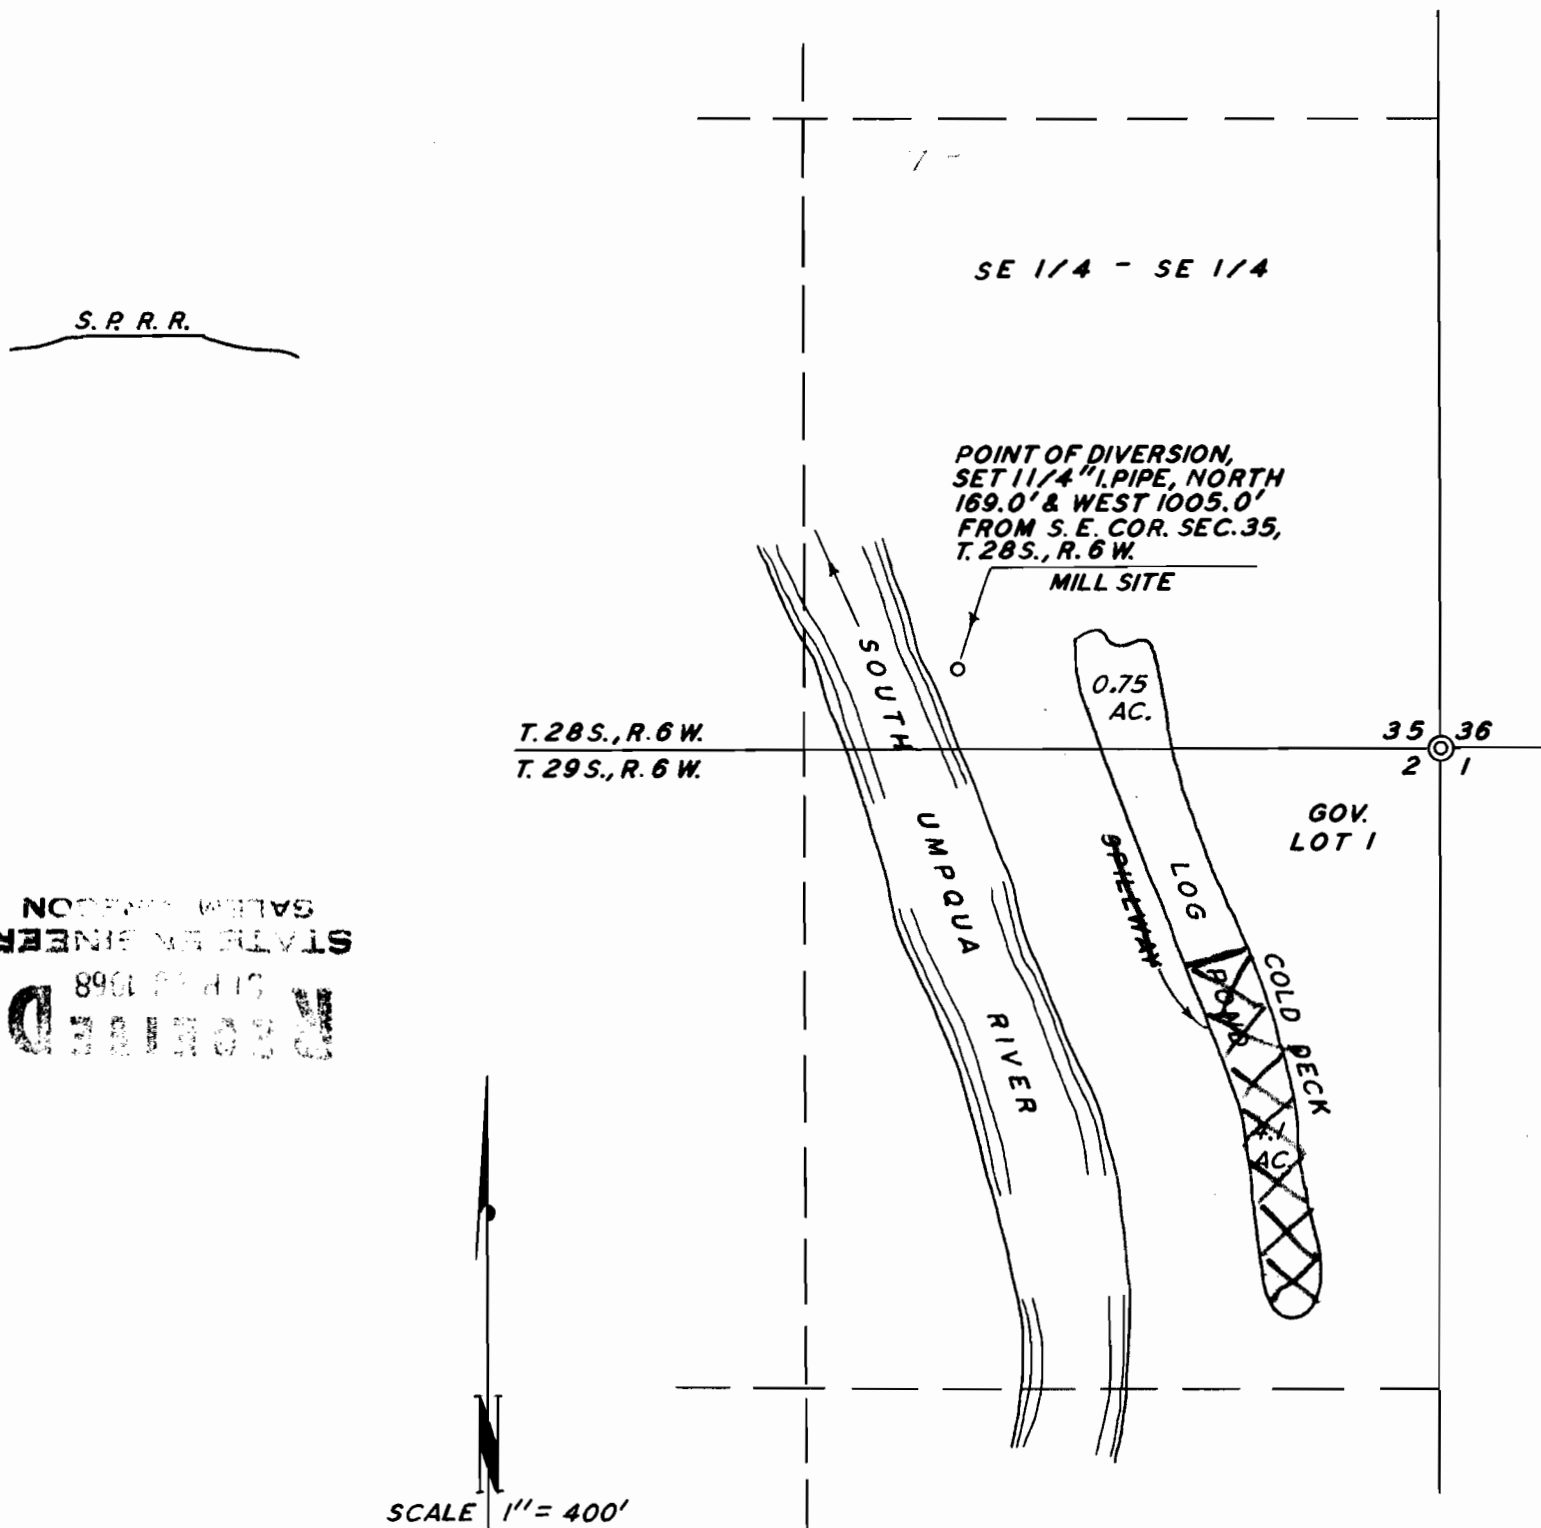

S. P. R. R.

SE 1/4 - SE 1/4

POINT OF DIVERSION,  
SET 1 1/4" PIPE, NORTH  
169.0' & WEST 1005.0'  
FROM S. E. COR. SEC. 35,  
T. 28S., R. 6W.

MILL SITE

T. 28S., R. 6W.  
T. 29S., R. 6W.

35 36  
2 1

GOV.  
LOT 1

STATE ENGINEER  
SALEM, OREGON  
OCT 1 1968  
**RECEIVED**


SCALE 1" = 400'

17-10-103-10

Round Prairie Lbr Co  
Dillard, Oregon

R-45412  
45286


RECEIVED  
OCT 1 1969  
STATE ENGINEER  
SALEM, OREGON

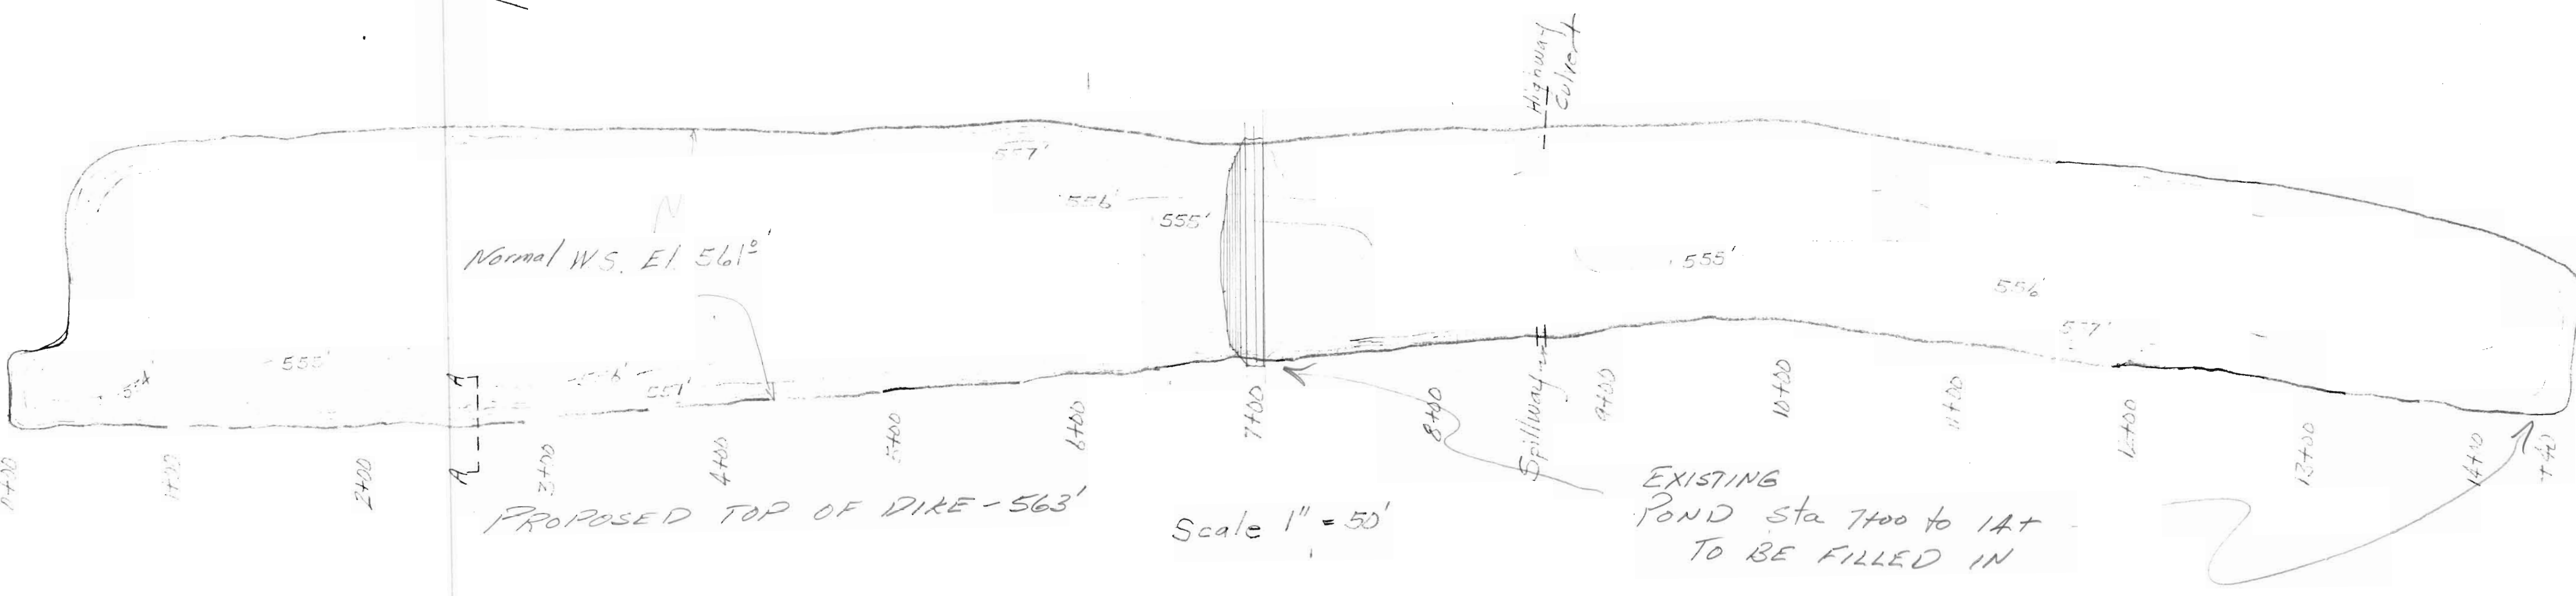

PROPOSED TOP OF DIKE - 563'

Scale 1" = 50'

EXISTING POND Sta 7+00 to 14+ TO BE FILLED IN

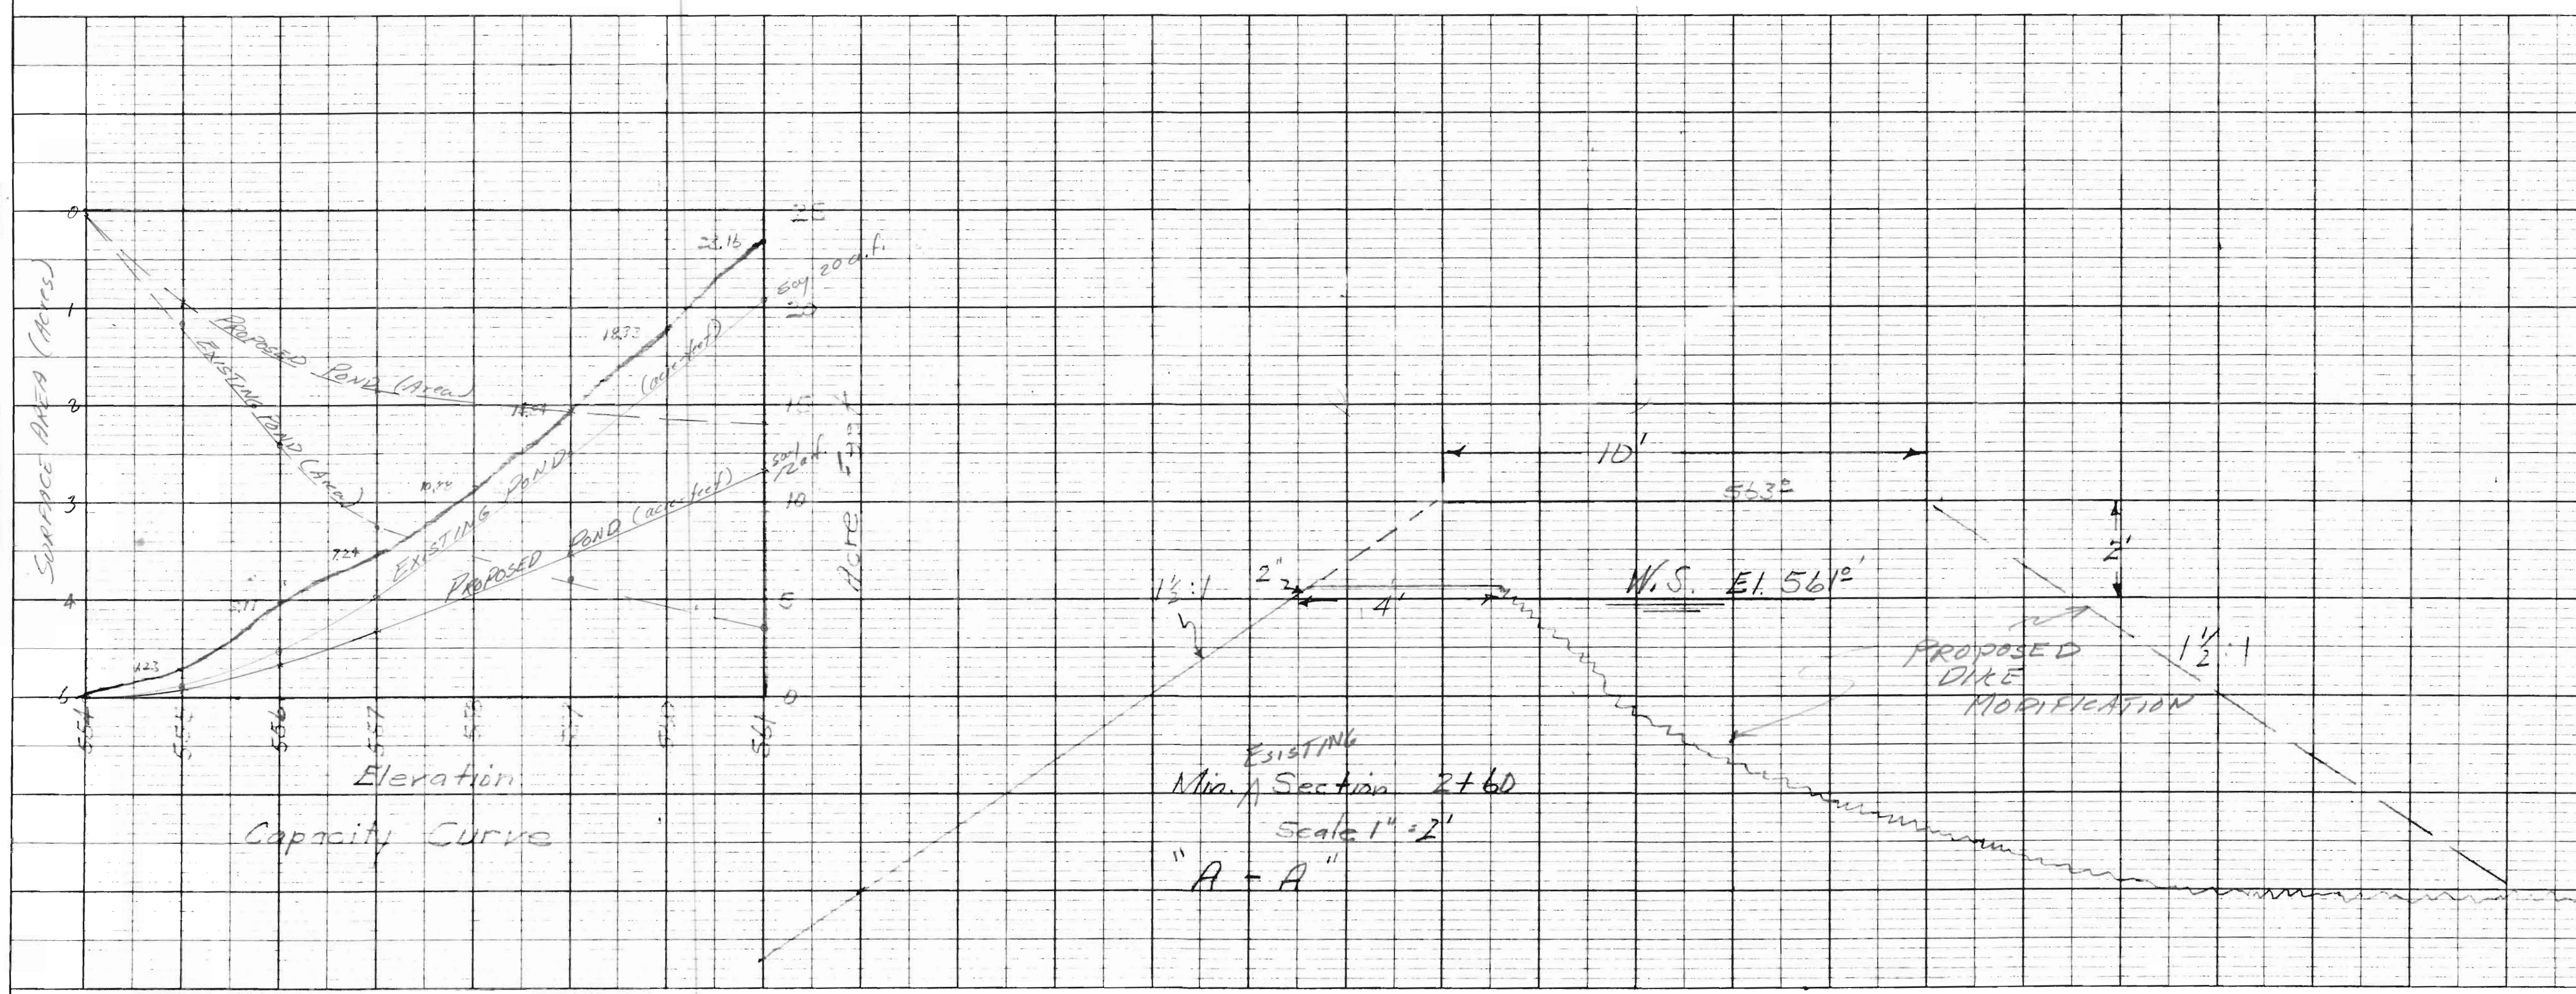

EXISTING Pond (acres) 501/2000  
"A-A"  
Scale 1" = 2'

Log

| Station | Dike width | Height above N.S. |
|---------|------------|-------------------|
| 0+00    | 13'        | 18"               |
| 1+00    | 15'        | 24"               |
| 2+00    | 11'        | 19"               |
| 2+60    | 4'         | 2"                |
| 3+00    | 4.5'       | 3"                |
| 4+00    | 8.5'       | 7"                |
| 5+00    | 8'         | 7"                |
| 6+00    | 8'         | 7"                |
| 7+00    | 11'        | 7"                |
| 7+50    | 11'        | 9"                |
| 8+00    | 12'        | 12"               |
| 9+00    | 10'        | 12"               |
| 10+00   | 8'         | 26"               |
| 11+00   | 8'         | 30"               |
| 12+00   | 12'        | 36"               |
| 12+00   | 12'        | 36"               |
| 14+00   | 14'        | 36"               |

RECEIVED  
SEP 19 1969  
STATE ENGINEER  
SALEM, OREGON

Application No. R-45412  
Permit No. R 5460  
Sept 15, 1969

PLAN  
DATE  
BY  
REVISIONS  
NO. 1  
NO. 2  
NO. 3  
NO. 4  
NO. 5  
NO. 6  
NO. 7  
NO. 8  
NO. 9  
NO. 10  
NOTE BOOK  
ALIGNMENT CHECKED  
BY  
DATE  
STRUCTURE NOTATIONS CHECKED  
BY  
DATE

PROFILE  
DATE  
BY  
REVISIONS  
NO. 1  
NO. 2  
NO. 3  
NO. 4  
NO. 5  
NO. 6  
NO. 7  
NO. 8  
NO. 9  
NO. 10  
NOTE BOOK  
GRADES CHECKED  
BY  
DATE  
STRUCTURE NOTATIONS CHECKED  
BY  
DATE