


23

24

1/4 COR.

26

509  
25 E 02

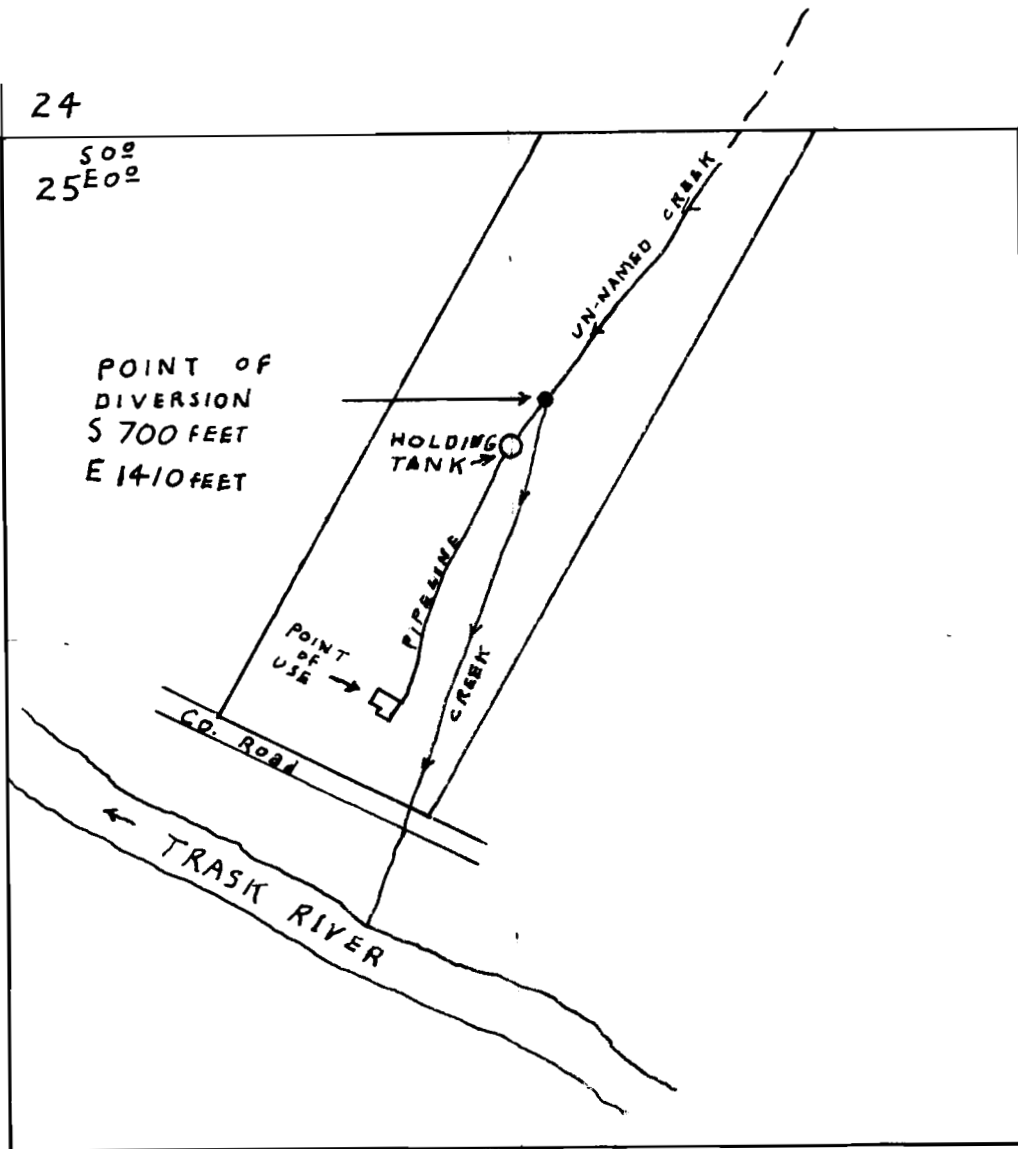

1/4 COR.

HIPPERT WATER RIGHT  
NW 1/4, SEC. 25 T. 15. R. 8W

APRIL 1969

SCALE 1" = 500'

RECEIVED  
STATE ENGINEER  
SALEM, OREGON

45758

34328