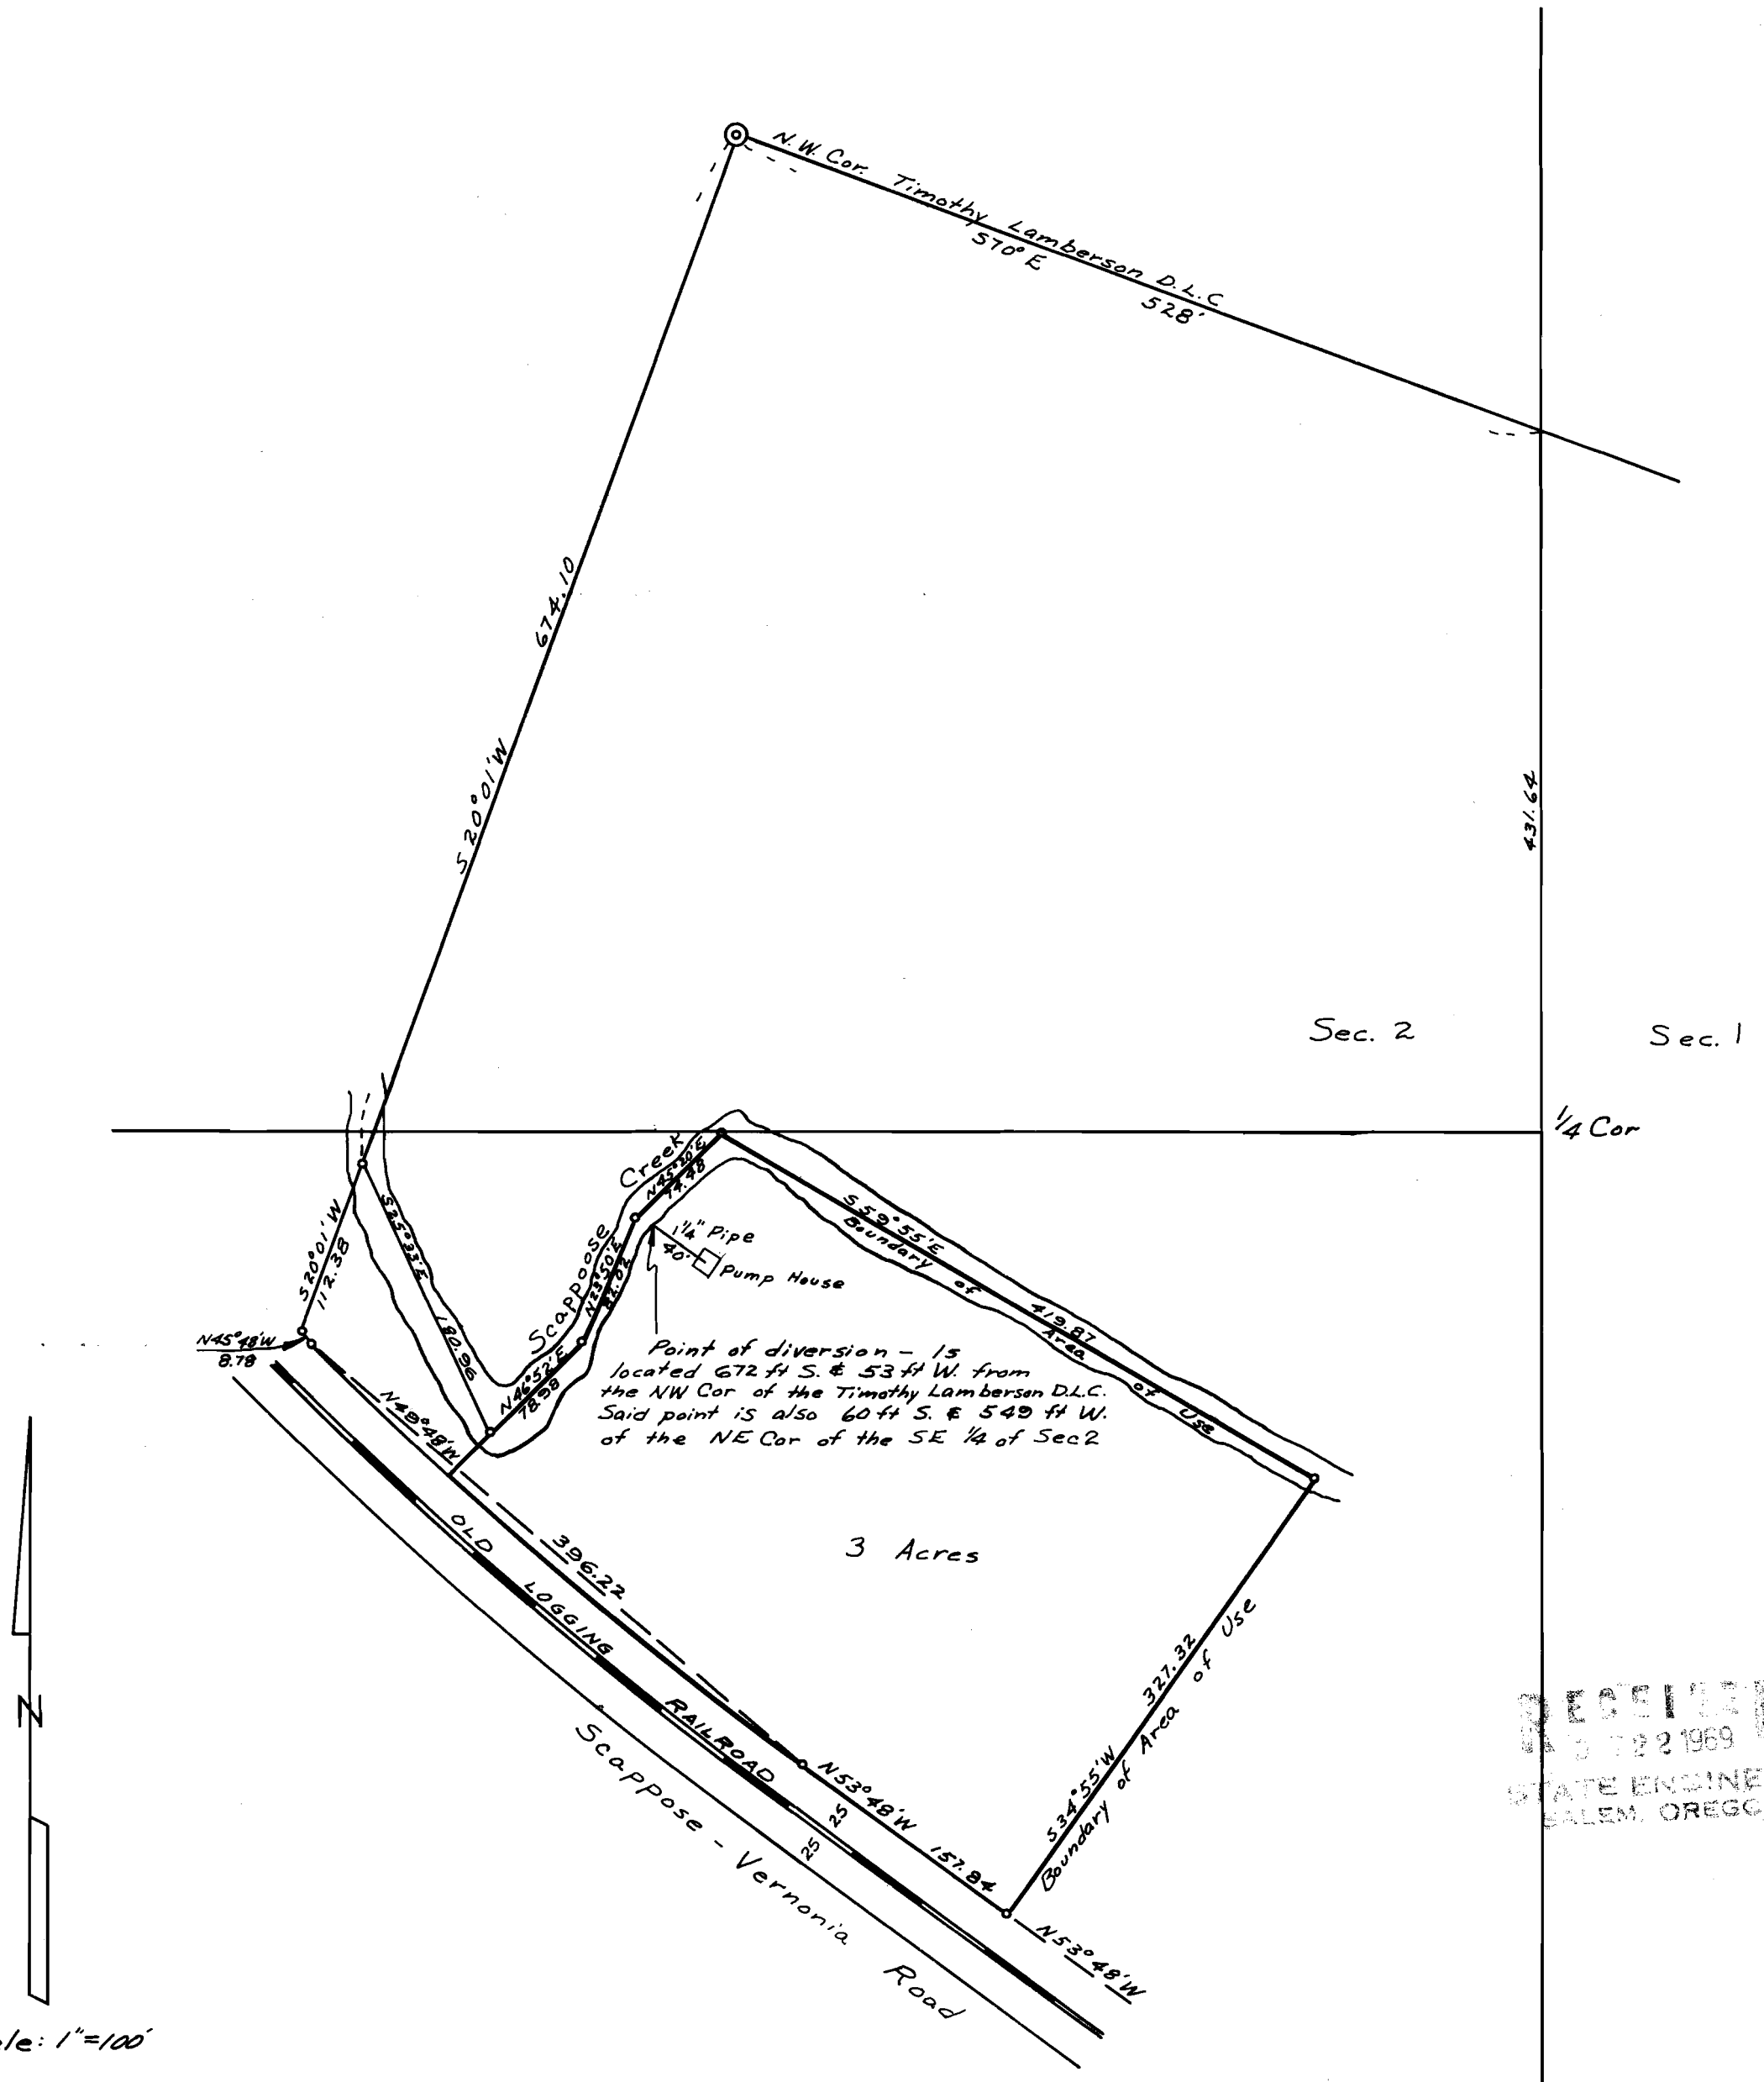


RECEIVED
AUG 22 1969
STATE ENGINEER
SALEM, OREGON

# WATER RIGHT MAP
## FOR CEDAR LANE TRAILER PARK

In Timothy Lamberson D.L.C., Sec. 2, T3N, R2W, W.M.
Columbia County, Oregon
August 6, 1969

REGISTERED
OREGON
LAND SURVEYOR

Philip Dewey

JULY 12, 1968
PHILIP DEWEY
847

Application No. 46432
Permit No. 34403