

- THOMAS CR. & UNK. TRUB, STUMP CR., FOX CR., ELLIOTT CR., E. E. FOX, ELLIOTT CR.
- HOWARD CR., CRAM CR., JOHNSON CR., & BRUSH CR.
- NORTH FORK CROOKED RIVER
- ALLEN CR. & ALLEN CR. RESERVOIR *
- PETERSON CR. & PETERSON CR. RESERVOIR

* LANDS IRRIGATED FROM FOX AND ELLIOTT CREEKS ALSO IRRIGATED FROM ALLEN CREEK RESERVOIR.

PRIMARY IRRIGATION UNDER THESE PERMITS PRIOR RIGHTS

DIRECTIONS POINTS LOCATED:

- 350 FT. S. AND 350 FT. W. FROM E 1/4 COR. SEC. 36
- 350 FT. N. AND 350 FT. W. FROM W 1/4 COR. SEC. 31
- 350 FT. N. AND 175 FT. W. FROM SE COR. SEC. 32
- 1050 FT. S. AND 40 FT. W. FROM E 1/4 COR. SEC. 32
- 350 FT. S. AND 150 FT. W. FROM N 1/4 COR. SEC. 1
- 530 FT. S. AND 850 FT. W. FROM E 1/4 COR. SEC. 12
- 150 FT. N. AND 550 FT. W. FROM SE COR. SEC. 13
- 350 FT. N. AND 715 FT. E. FROM SW COR. SEC. 14
- 160 FT. N. AND 450 FT. E. FROM SW COR. SEC. 14
- T. 14 S. R. 20 E. W. M.
- 350 FT. N. AND 480 FT. W. FROM SE COR. SEC. 2
- 350 FT. S. AND 800 FT. W. FROM N 1/4 COR. SEC. 8
- 350 FT. S. AND 150 FT. W. FROM N 1/4 COR. SEC. 9
- 350 FT. S. AND 150 FT. E. FROM W 1/4 COR. SEC. 9
- 350 FT. S. AND 300 FT. W. FROM NE COR. SEC. 11
- 350 FT. S. AND 350 FT. W. FROM NE COR. SEC. 11
- 350 FT. S. AND 350 FT. W. FROM NE COR. SEC. 11
- 150 FT. N. AND 800 FT. E. FROM SW COR. SEC. 25 1/2
- 150 FT. S. AND 150 FT. E. FROM NE COR. SEC. 15
- 250 FT. S. AND 150 FT. W. FROM NE COR. SEC. 17
- 2500 FT. S. AND 250 FT. E. FROM NW COR. SEC. 19
- 150 FT. N. AND 200 FT. W. FROM E 1/4 COR. SEC. 29
- T. 14 S. R. 21 E. W. M.

FINAL PROOF SURVEY

UNDER

Application No. R-28669 Permit No. R-1554


28665	22573
29712	23391
R-29713	R-1710
29714	23392
30100	24774
R-30753	R-2000
30754	24775
R-46546	R-5479
46547	34405

IN NAME OF
BOSTON RANCH COMPANY

SURVEYED June 22 thru July 3, 1970 by D. BULL
 Oct. 1969 by L. E. ROUSE
 Inspected July, 1963 by T. LAUER
 Sep. 1960 by R. JOHNSON

E-42-15

RECEIVED
 DEC 15 1969
 STATE ENGINEER
 SALEM, OREGON

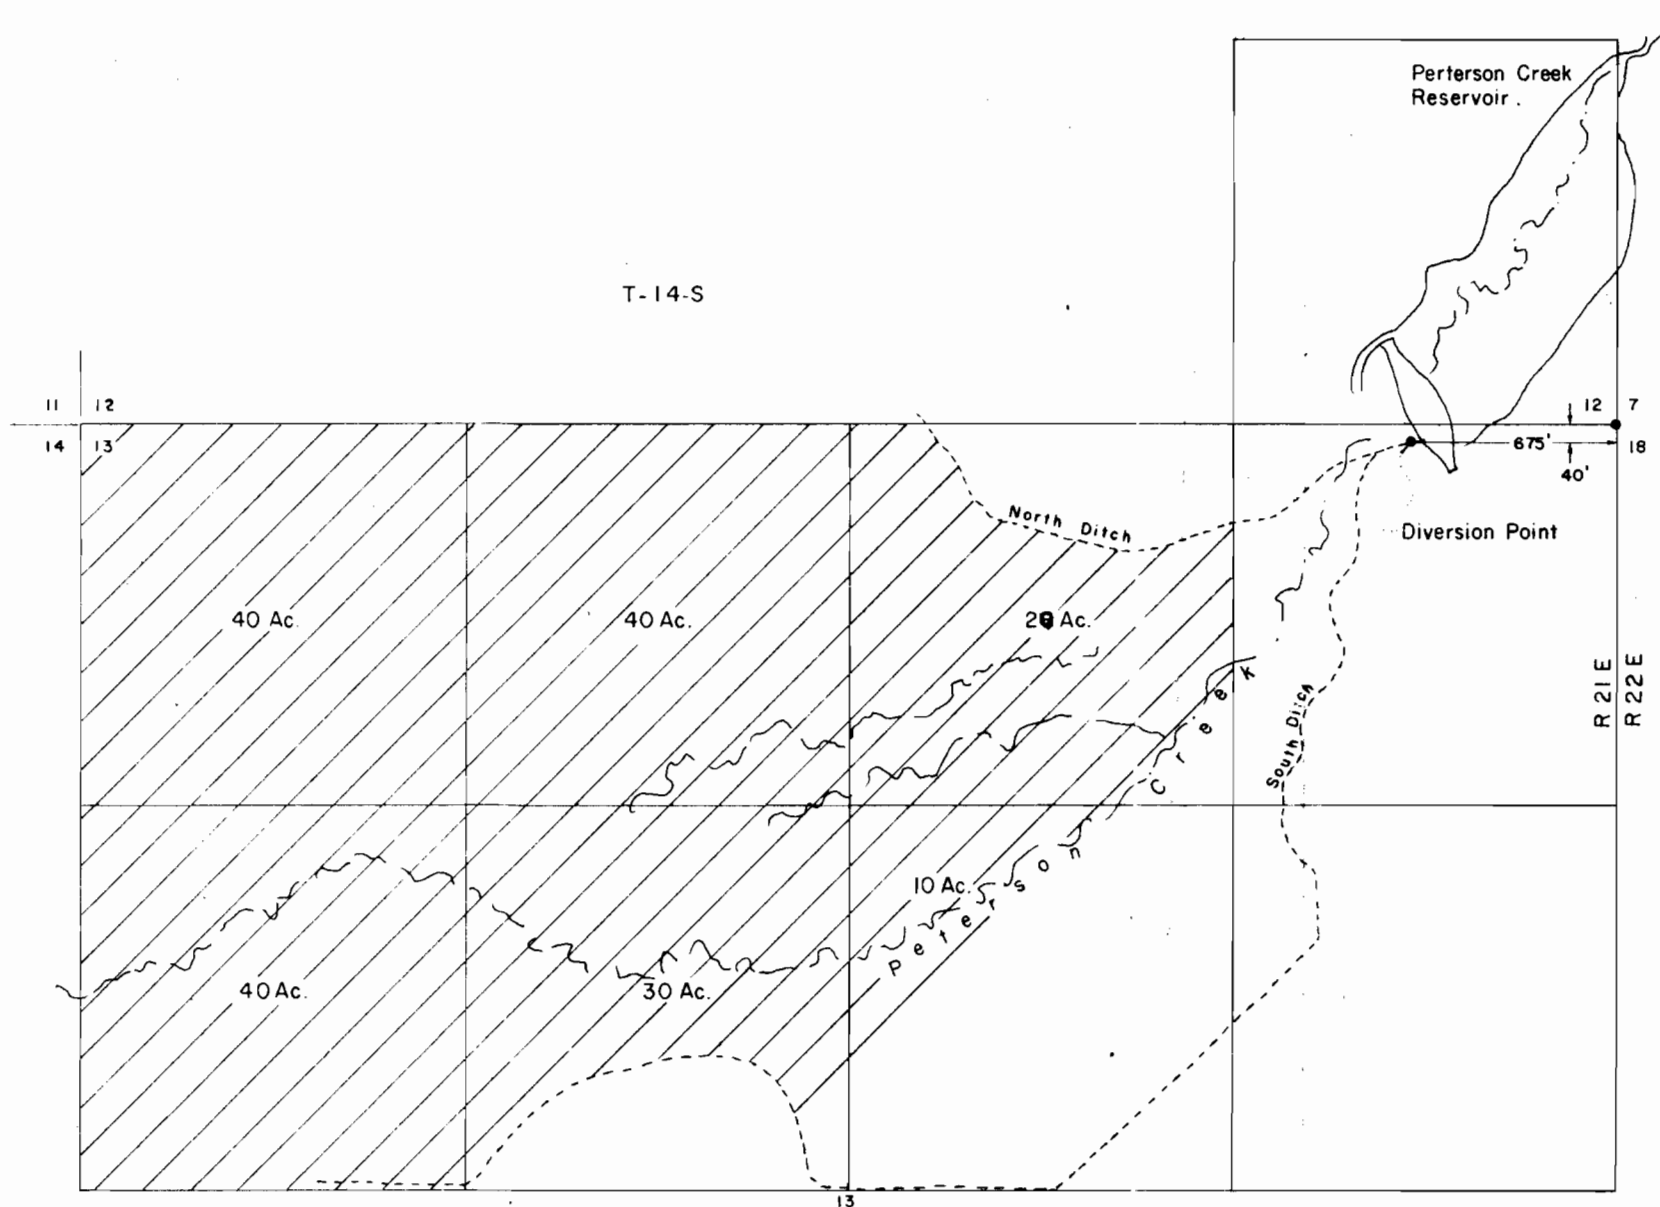

PETERSON CREEK SERVICE AREA		
NORTH HALF OF SECTION 13, T14S, R21E		
Scale: 1" = 660'	Approved by:	Drawn by: D.L. Waggle
Date: Dec. 1969		Revised:
BOSTON RANCH COMPANY		
Prineville		Oregon

R-16996
 46547
 R 21E
34405
 R 5479