


JOHN H. & LAURA BENNETT
WATER RIGHT APPLICATION
SECTION 23, TOWNSHIP 17 SOUTH
RANGE 10 WEST W.M.

RECEIVED
AUG 14 1969
STATE ENGINEER
SALEM, OREGON

RECEIVED
OCT 20 1969
STATE ENGINEER
SALEM, OREGON

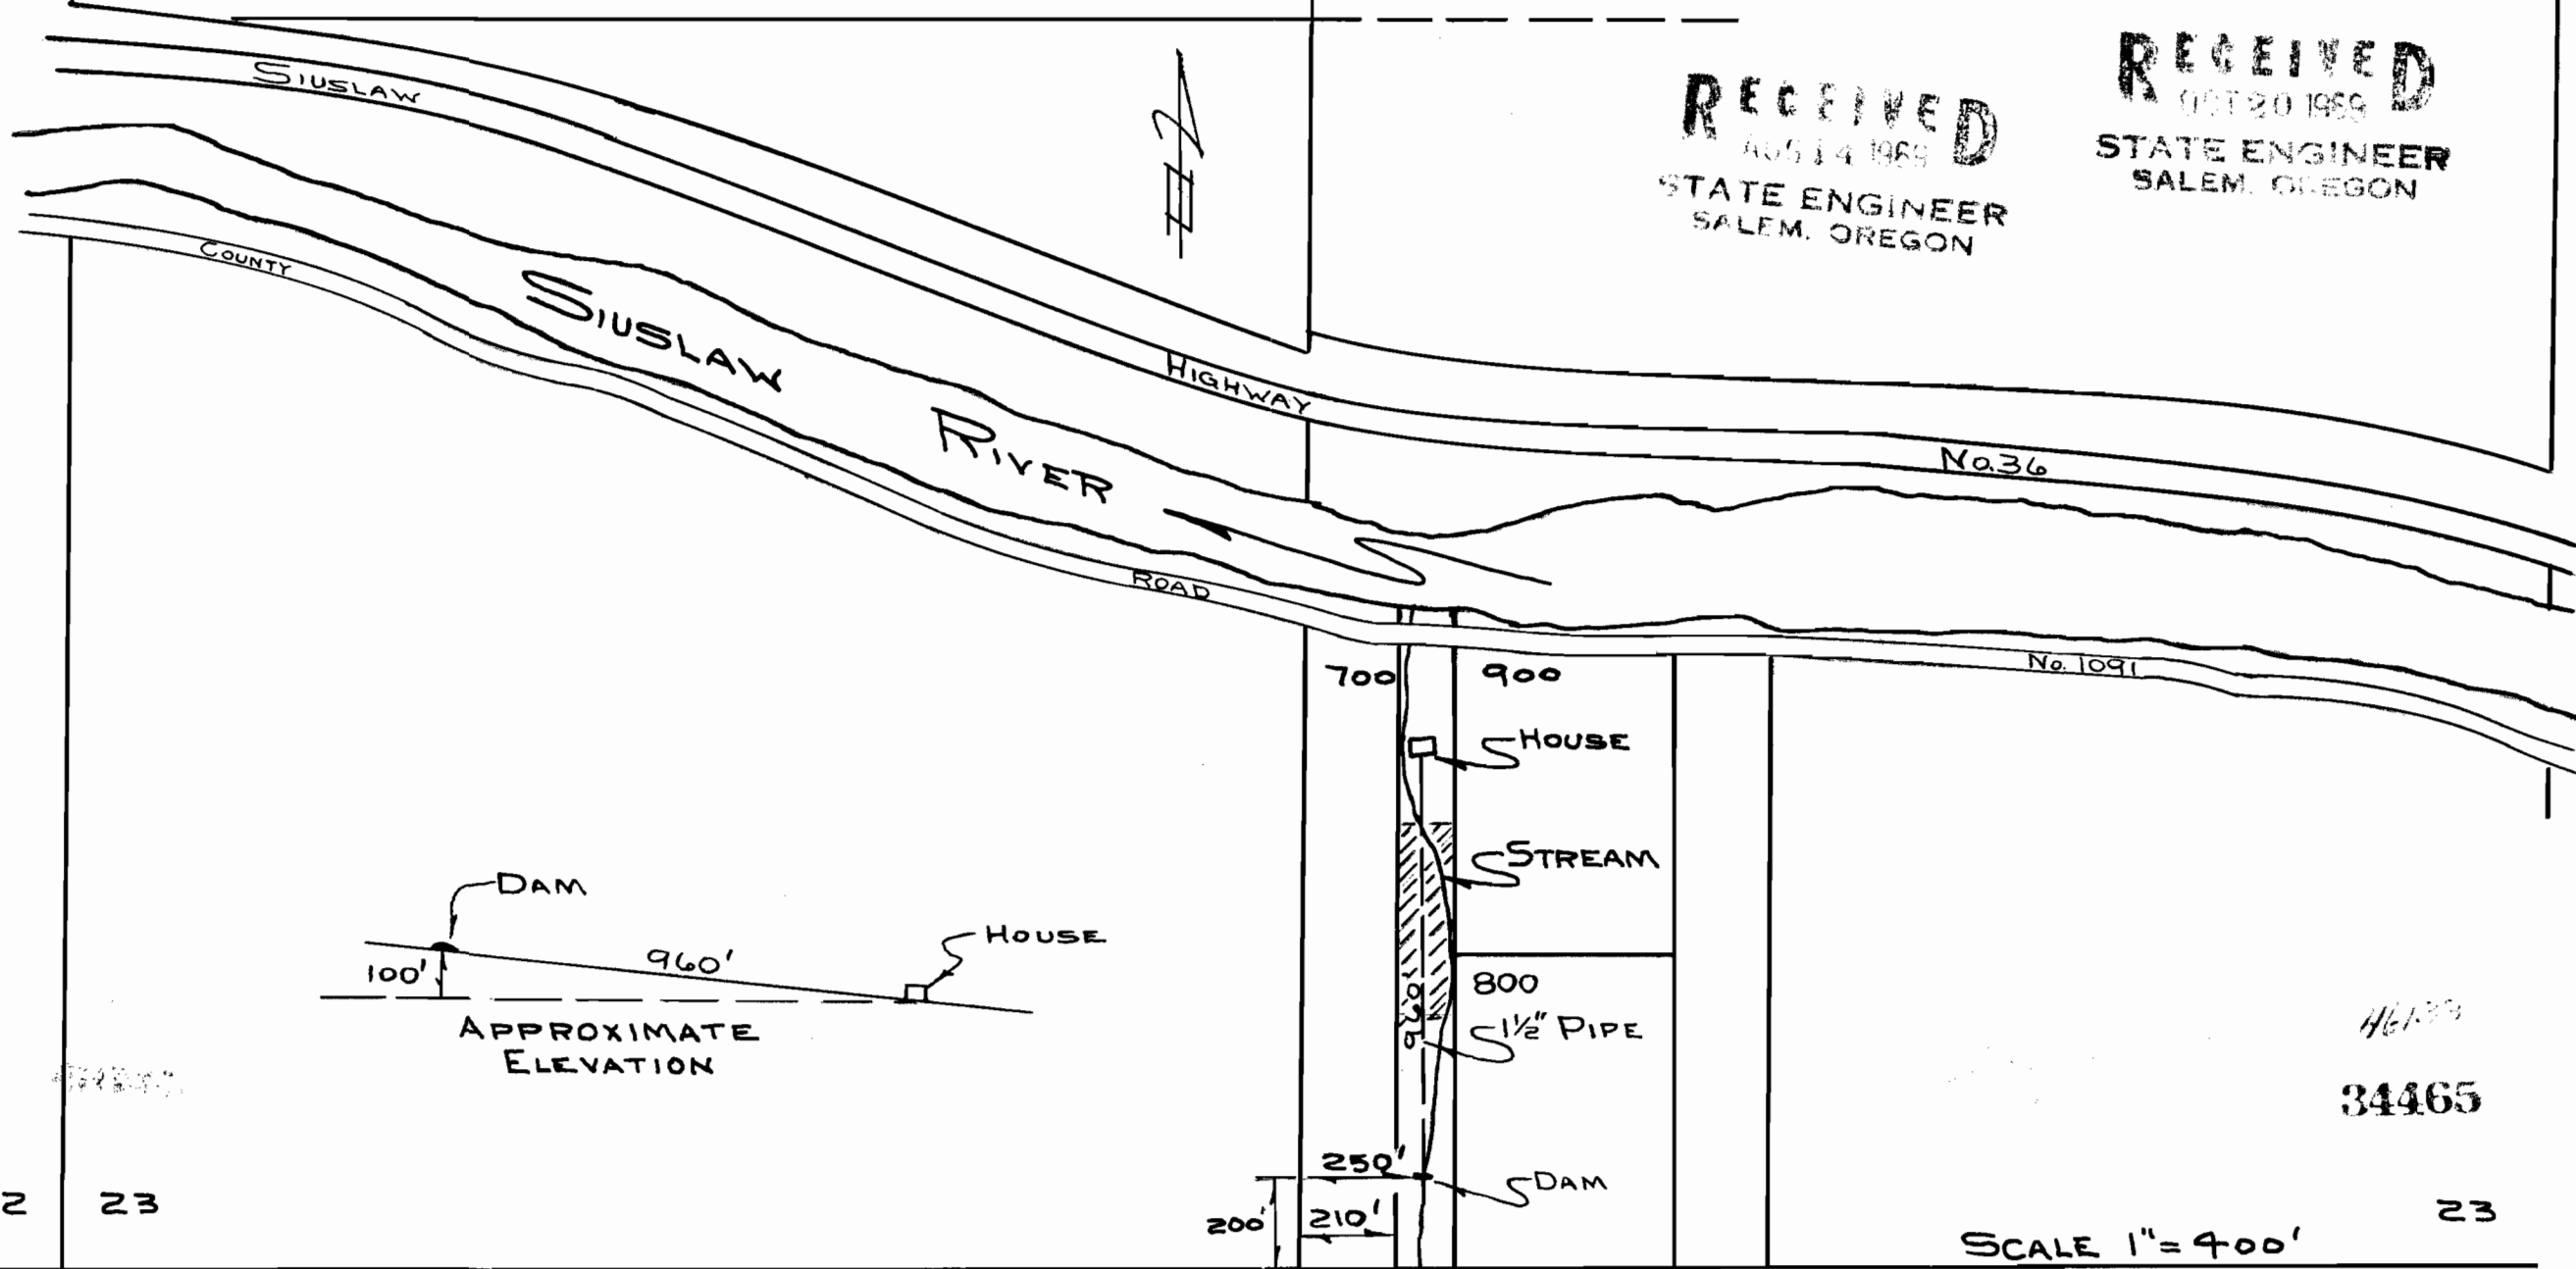

461-79

34465

SCALE 1" = 400'

23