


34519

T.35S. R.7W. W.M.

RECEIVED

NOV 24 1976

WM. DIST. 14
GRANTS PASS, ORE.

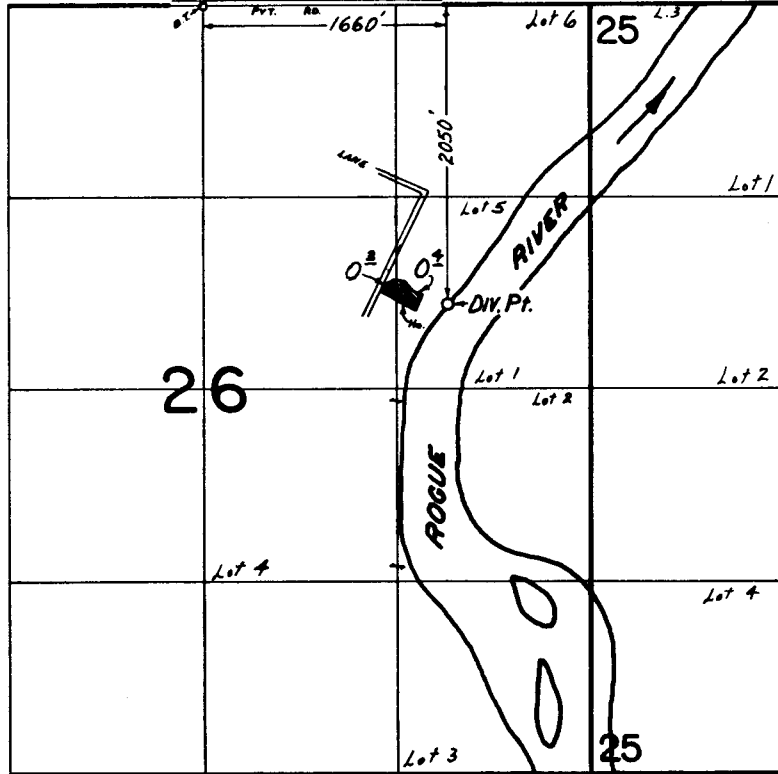

**FINAL PROOF SURVEY
UNDER**

Application No. 46201 Permit No. 34519
IN NAME OF

ALLEN R. SPOTTS

Surveyed MAY 16, 1974, by L. E. GOULD

P.T.S. 1974-K 808