
## T.40S.,R.8W.,W.M.

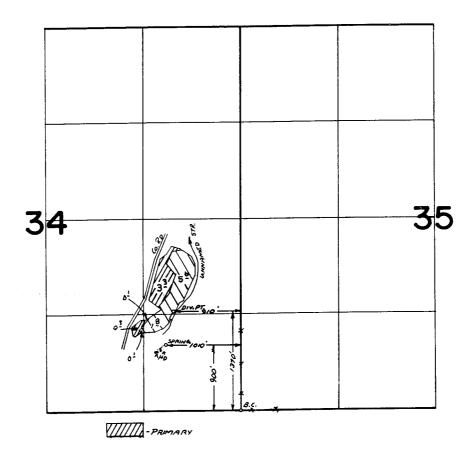

## **RECEIVED**

JUN 2 1 1978

WM. DIST. 14 GRANTS PASS, ORE.

## FINAL PROOF SURVEY

Application No. 46	1097 245 Permit NAME OF	No. 34550
GOLDEN	V. MAYL	ONE
Surveyed Max. 2	19.75, by	L. Tall