


# T.34 S. R.6 W. W.M.

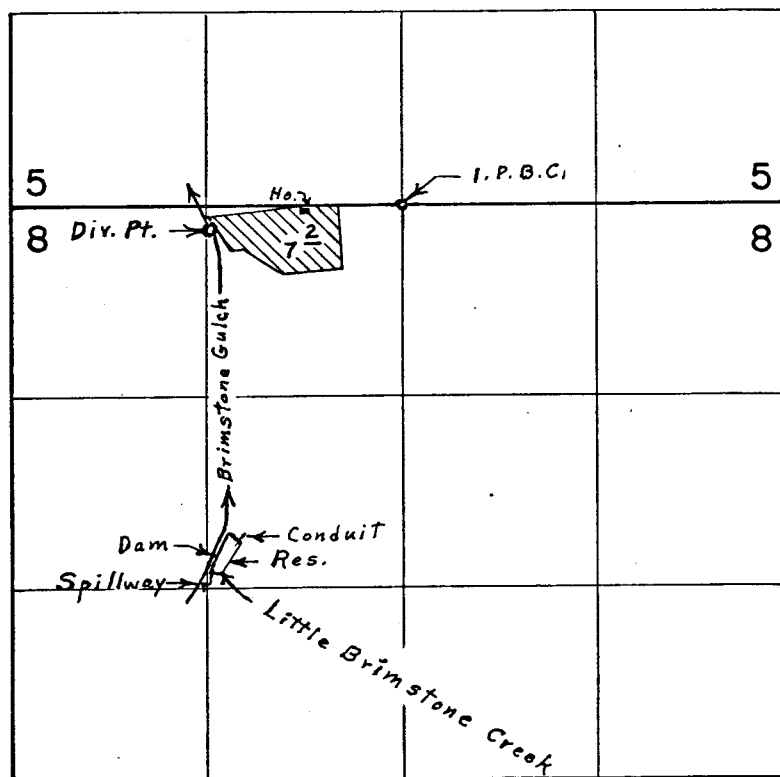

Div. Pts. located: Little Brimstone Creek, 2530'S. & 1230'W.;  
 Brimstone Gulch Creek, 170'S. & 1300'W., both from N.  $\frac{1}{4}$  Cor. Sec. 8

RECEIVED  
 AUG 8 1978  
 WM. DIST. 14  
 GRANTS PASS. ORE

## FINAL PROOF SURVEY UNDER

R-49010                      R-5945  
 R-46263                      R-5504  
 Application No. 46264    Permit No. 34563  
 IN NAME OF

CARL F. EHLIG

Surveyed April 5, 1975, by L. E. Gould.