


T.1S. R.3W. W.M.

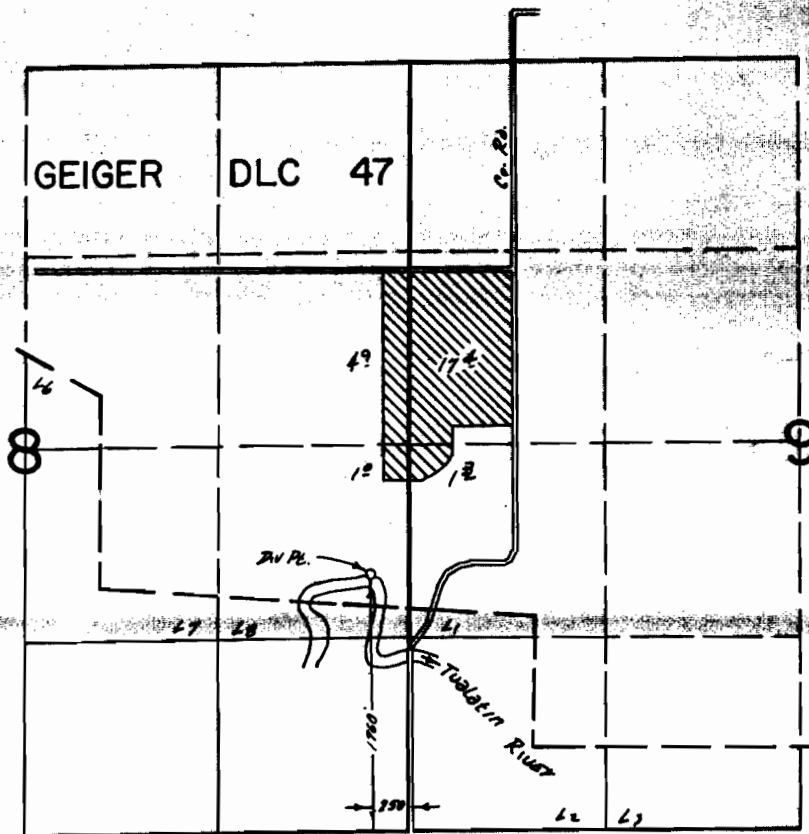

FINAL PROOF SURVEY
UNDER

Application No. 46569.. Permit No. 34665..
IN NAME OF

HAROLD DUNCALF

Surveyed Sep. 4... 1974., by R. G. MUCKEN