


34693

T.36S.R.7W.W.M.

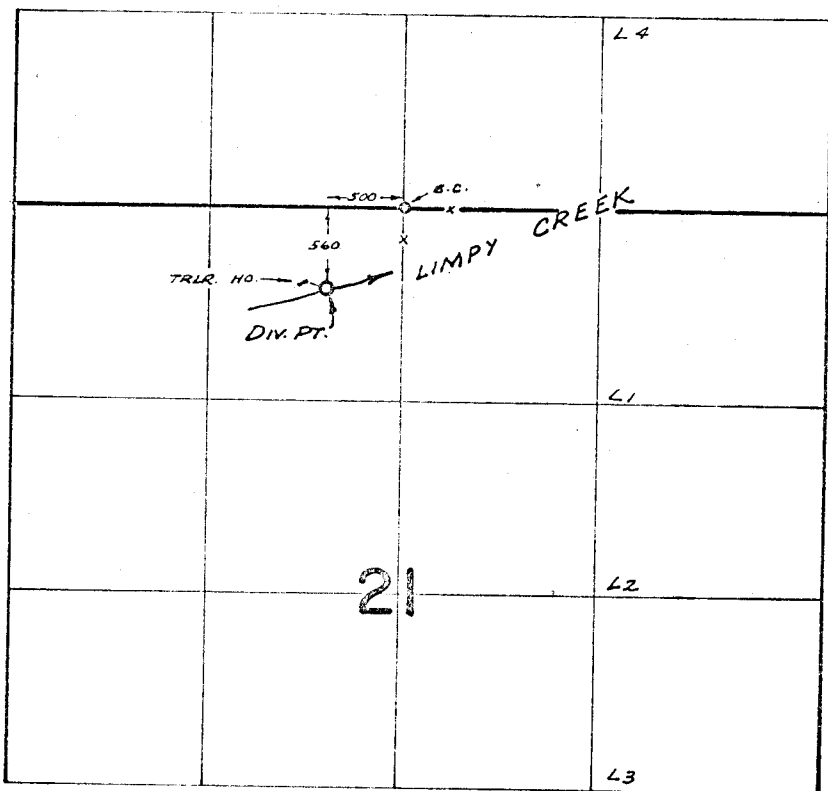

**FINAL PROOF SURVEY**  
UNDER

Application No. 46434 Permit No. 34693  
IN NAME OF

ROYAL E. HANSEN

Surveyed APR. 19, 1972, by R. MUCKEN