


Application No. 46460
Permit No. 34914

RECEIVED
FEB 18 1970
STATE ENGINEER
SALEM, OREGON

T.G.S. R.I.E.W.M.

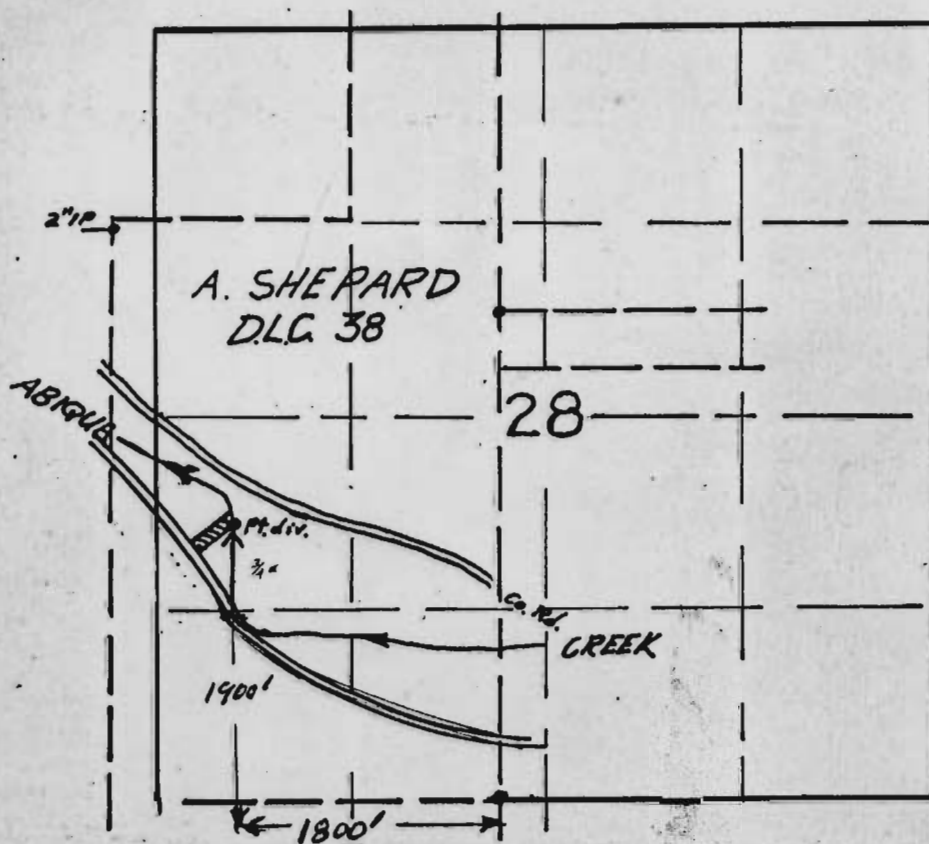

1900 N & 1800' W from SE Cor DLC 38