


RECEIVED
AUG 7 1917
SALMON - OREGON


Township To. 35 South, Range To. 6 West of the Willamette Meridian

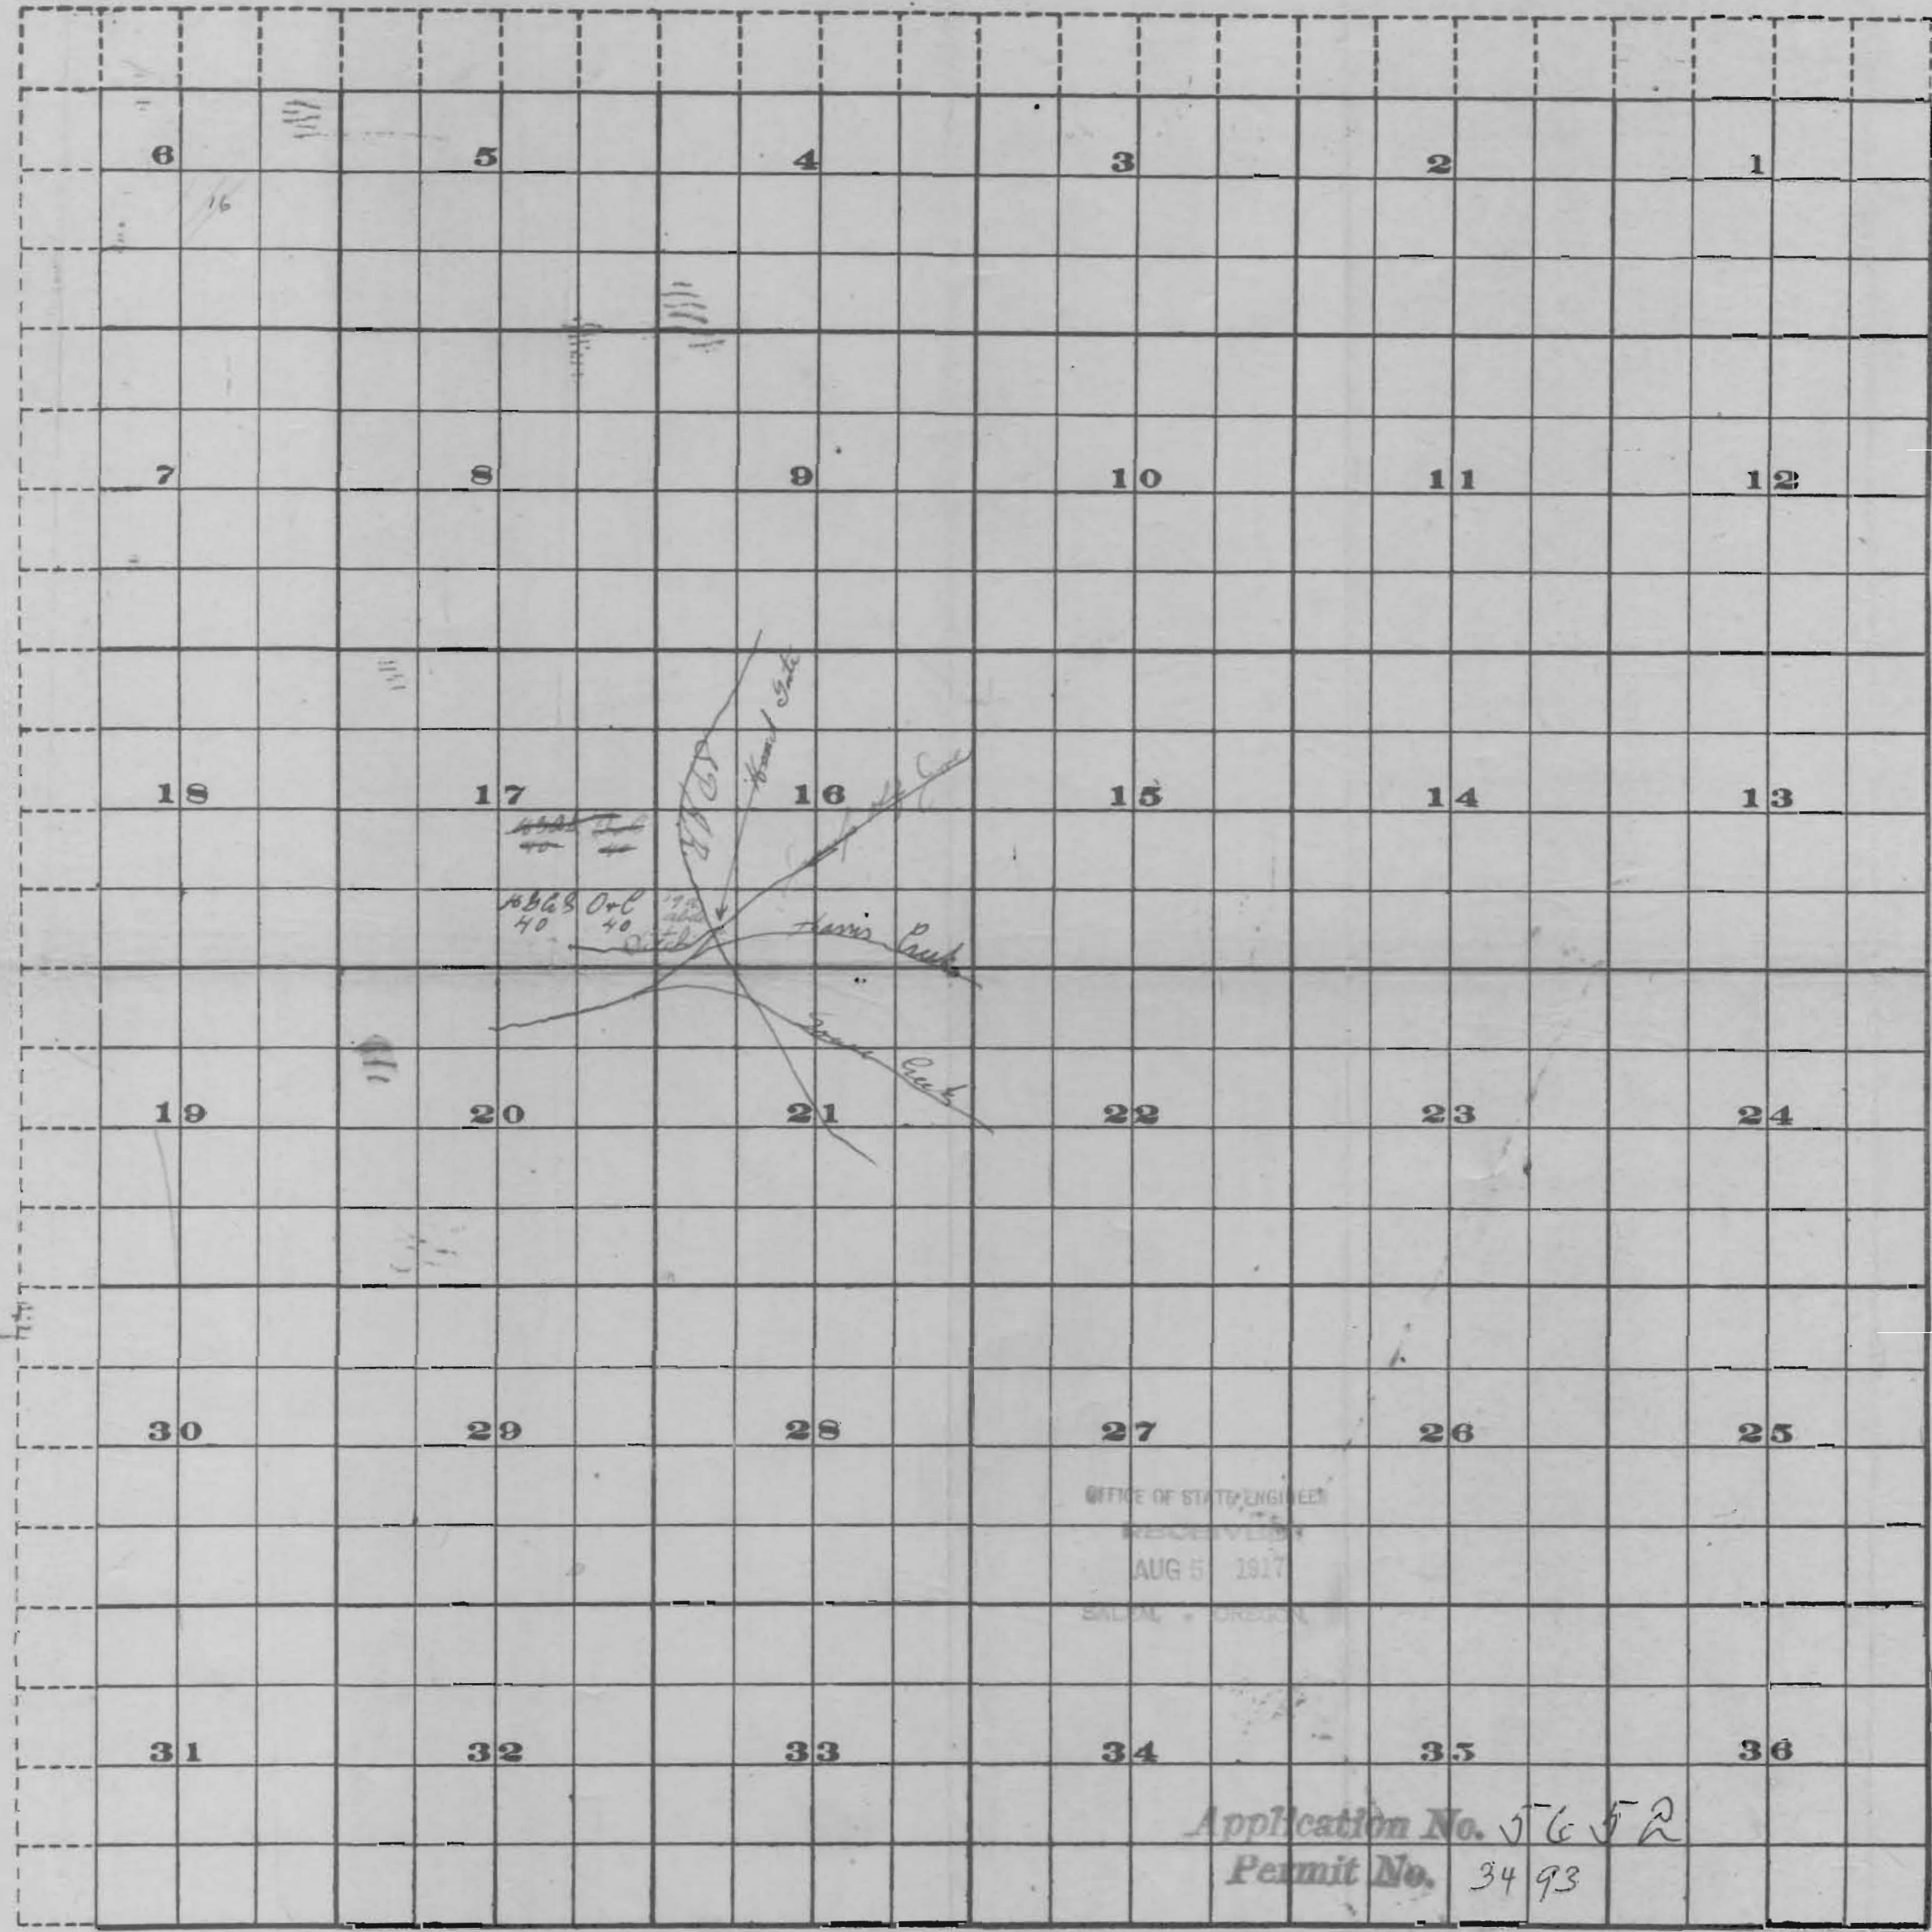

11.2

5250

5250

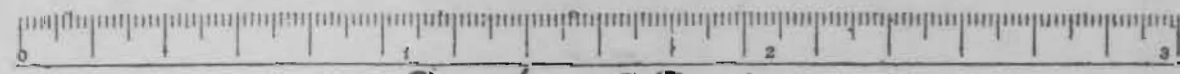

Scale of Feet.

FROM OFFICE OF THE STATE ENGINEER, SALMON, OREGON